

CORNER REPORT FORM

FILED

Section 35 Township 32S Range 7W
Douglas County Date 8/2014
PLSS Number 600120

Date: 8-26-2014 By: JC
This survey consists of:
Map: _____
Narrative: _____
Corner Rpt: CS65/86-11

DOUGLAS COUNTY
SURVEYOR

CORNER DESIGNATION

5 1/16 35/36

- Condition report only
- Not Found
- Renewed
- Unrecorded
- Surveyed In
- Referenced out

Previous Renewals/Surveys, etc:

RONALD BRANDT M.83-29

Monument(s) & Accessories Found: (Condition and Source)

1" IRON PIPE
A 27" D. FIR S29°E 103 1/2 FT HEA/ED SUNK

Monument Detail

Sketch

Monument Set (Procedures and Description)

New Accessories

A 5" FIR S14W 19 1/2 FT Scribed 5 1/16 S35BT



Surveyor's Seal

Location & Comments

AREA BURNED AUG.
2013

Compass Declination 15 1/2
Firm/Agency: i.e. Engineering, Inc.
Address: 809 SE Pine St., Roseburg, OR 97470

Party Chief: N. FROMDAHL
Notes:
Witness: R. OLSEN

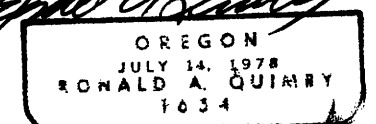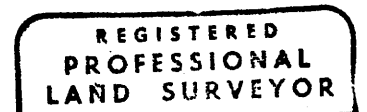

EXP 12-31-14

C.S. File CS 65/86-11