

CORNER REPORT FORM

FILED

Section 33 Township 32S Range 4W
Douglas County Date 9-20-14
PLSS Number 340100

Date: 9-17-2014 By: JC
This survey consists of:
Map: _____
Narrative: _____
Corner Rpt: CS 65/86-17
DOUGLAS COUNTY
SURVEYOR

CORNER DESIGNATION

S 1/4 COR SEC 33 ONLY

- Condition report only
- Not Found
- Renewed
- Unrecorded
- Surveyed In
- Referenced out

Previous Renewals/Surveys, etc:

PRICE 1954 CS 41/301
Templin 1995 M 122-53

Monument(s) & Accessories Found: (Condition and Source)

5/8" I. ROD TEMPLIN CAP
A 55" STUMP BRASS RECORD N 69 1/2 E 38 3/4 FT VIS. SCRIBE
10" D. FIR N 63 E 23 3/4 FT GOOD SCAR
14" MAPLE (REC ASH) S 53 E 6 5/8 FT GOOD SCAR

Monument Detail

Sketch

Monument Set (Procedures and Description)

New Accessories

24" MAPLE N 53 W 61 6/8 FT SCRIBE 1/4 533 BT



Surveyor's Seal

Location & Comments

AREA BADLY
BURNED 2013

Compass Declination 15 1/2
Firm/Agency: i.e. Engineering, Inc.
Address: 809 SE Pine St., Roseburg, OR 97470

Party Chief: N. FROHNDAL
Notes:
Witness: D. MAHRING

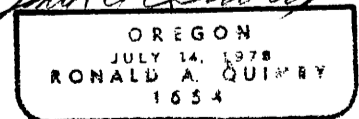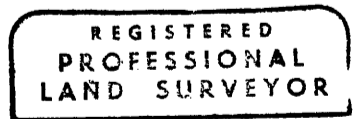

EXP 12-31-14

C.S. File 65/86-17