

CORNER REPORT FORM

FILED

Section 4 Township 33 Range 7
Douglas County Date 9/2014
PLSS Number 31100 T32-7
300700 T33-7

Date: 9/17/2014 By: JC
This survey consists of:
Map: _____
Narrative: _____
Corner Rpt: CS 65/86-21
DOUGLAS COUNTY
SURVEYOR

CORNER DESIGNATION

CC 415 only

- Condition report only
- Not Found
- Renewed
- Unrecorded
- Surveyed In
- Referenced out

Previous Renewals/Surveys, etc:

PRICE 1954 CS File 41/301
DCSO 1967 CS File 54/36
DCSO 1995 CS 64/64-5

Monument(s) & Accessories Found: (Condition and Source)

DCSO BRASS CAP
17" D. FIR S83E 15.8 FT GOOD SCAR
16" PINE S2W 25.0 FT " "
16" CHINGHAPIN S73W 59.1 FT VIS SCRIBE
26" PINE S47 1/2 W 92.5 FT GOOD SCAR

Monument Detail

DCSO BRASS CAP

Sketch

Monument Set (Procedures and Description)

New Accessories


Location & Comments

AREA burnt
2013
CORNER LIES ON
N.E SW Ridge approx
60' south of
RD Intersection

Compass Declination 15 1/2
Firm/Agency: i.e. Engineering, Inc.
Address: 809 SE Pine St., Roseburg, OR 97470

Party Chief: N. Frommelt
Notes:
Witness: D. MAURING

Surveyor's Seal

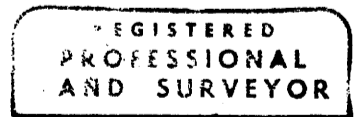

Ronald A. Quimby
OREGON
JULY 14, 1978
RONALD A. QUIMBY
1954

EXP 12-31-14

C.S. File 65/86-21