

Section 33 Township 32S Range 7W
Douglas County Date 9-2014
PLSS Number 300140

Date: 10-2-2014 By: [Signature]
This survey consists of:
Map: _____
Narrative: _____
Corner Rpt: CS 65/86-23
DOUGLAS COUNTY
SURVEYOR

CORNER DESIGNATION

1/4 COR 32/33

- Condition report only
- Not Found
- Renewed
- Unrecorded
- Surveyed In
- Referenced out

Previous Renewals/Surveys, etc:

PRICE 1954 CS 41/301
DCSO 1947 CS 54/36
Templin 1995 M 122-53

Monument(s) & Accessories Found: (Condition and Source)

FD 1 1/2" I. Pipe
13" MADRONA S 85° E 31.7 Hollow SCAR
29" MADRONA S 31° E 12.5 Hollow SCAR
40" INCENSE CEDAR N 70° W 32.3 FT GOOD SCAR

Monument Detail

Sketch

Monument Set (Procedures and Description)

New Accessories

6" FIR N 67° E 10⁶ FT Scribed 1/4 S 33 RT
6" FIR S 58° W 22⁶ FT Scribed 1/4 S 33 RT


Surveyor's Seal

Location & Comments

AREA BURNED
8-2013

Compass Declination 15 1/2°
Firm/Agency: i.e. Engineering, Inc.
Address: 809 SE Pine St., Roseburg, OR 97470

Party Chief: AL FROMM (N/A)
Notes:
Witness: R. OLSEN
D. MARRING

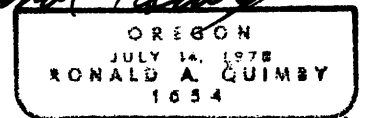

EXP 12-31-14

C.S. File CS 65/86-23