

FILED OCT 14 2014

CORNER'S FD TO
BE AS RECORDED
IN SEC 19 T31S
R9W

N.W. 1/16 SEC. 19

N 1/16 S24/S19

FD BLM BRASS

CAP'S & BT'S OF

RECORD

REGISTERED
PROFESSIONAL
LAND SURVEYOR

Ronald A. Quinlan

OREGON
JULY 11 1974
RONALD A. QUINLAN
1054

10/2014

EXP 12-31-14

C.S. File No 65/86-27A

Plum Creek
Standly Flat, N 1/16 S24, S19

FILED OCT 14 2014

"Found BT's"


14" Fir
S45°E
17.5'

Healed Blaze

26" Multi Forked Hemlock,
with several trunks

S36°W
33.7'

Healed Blaze

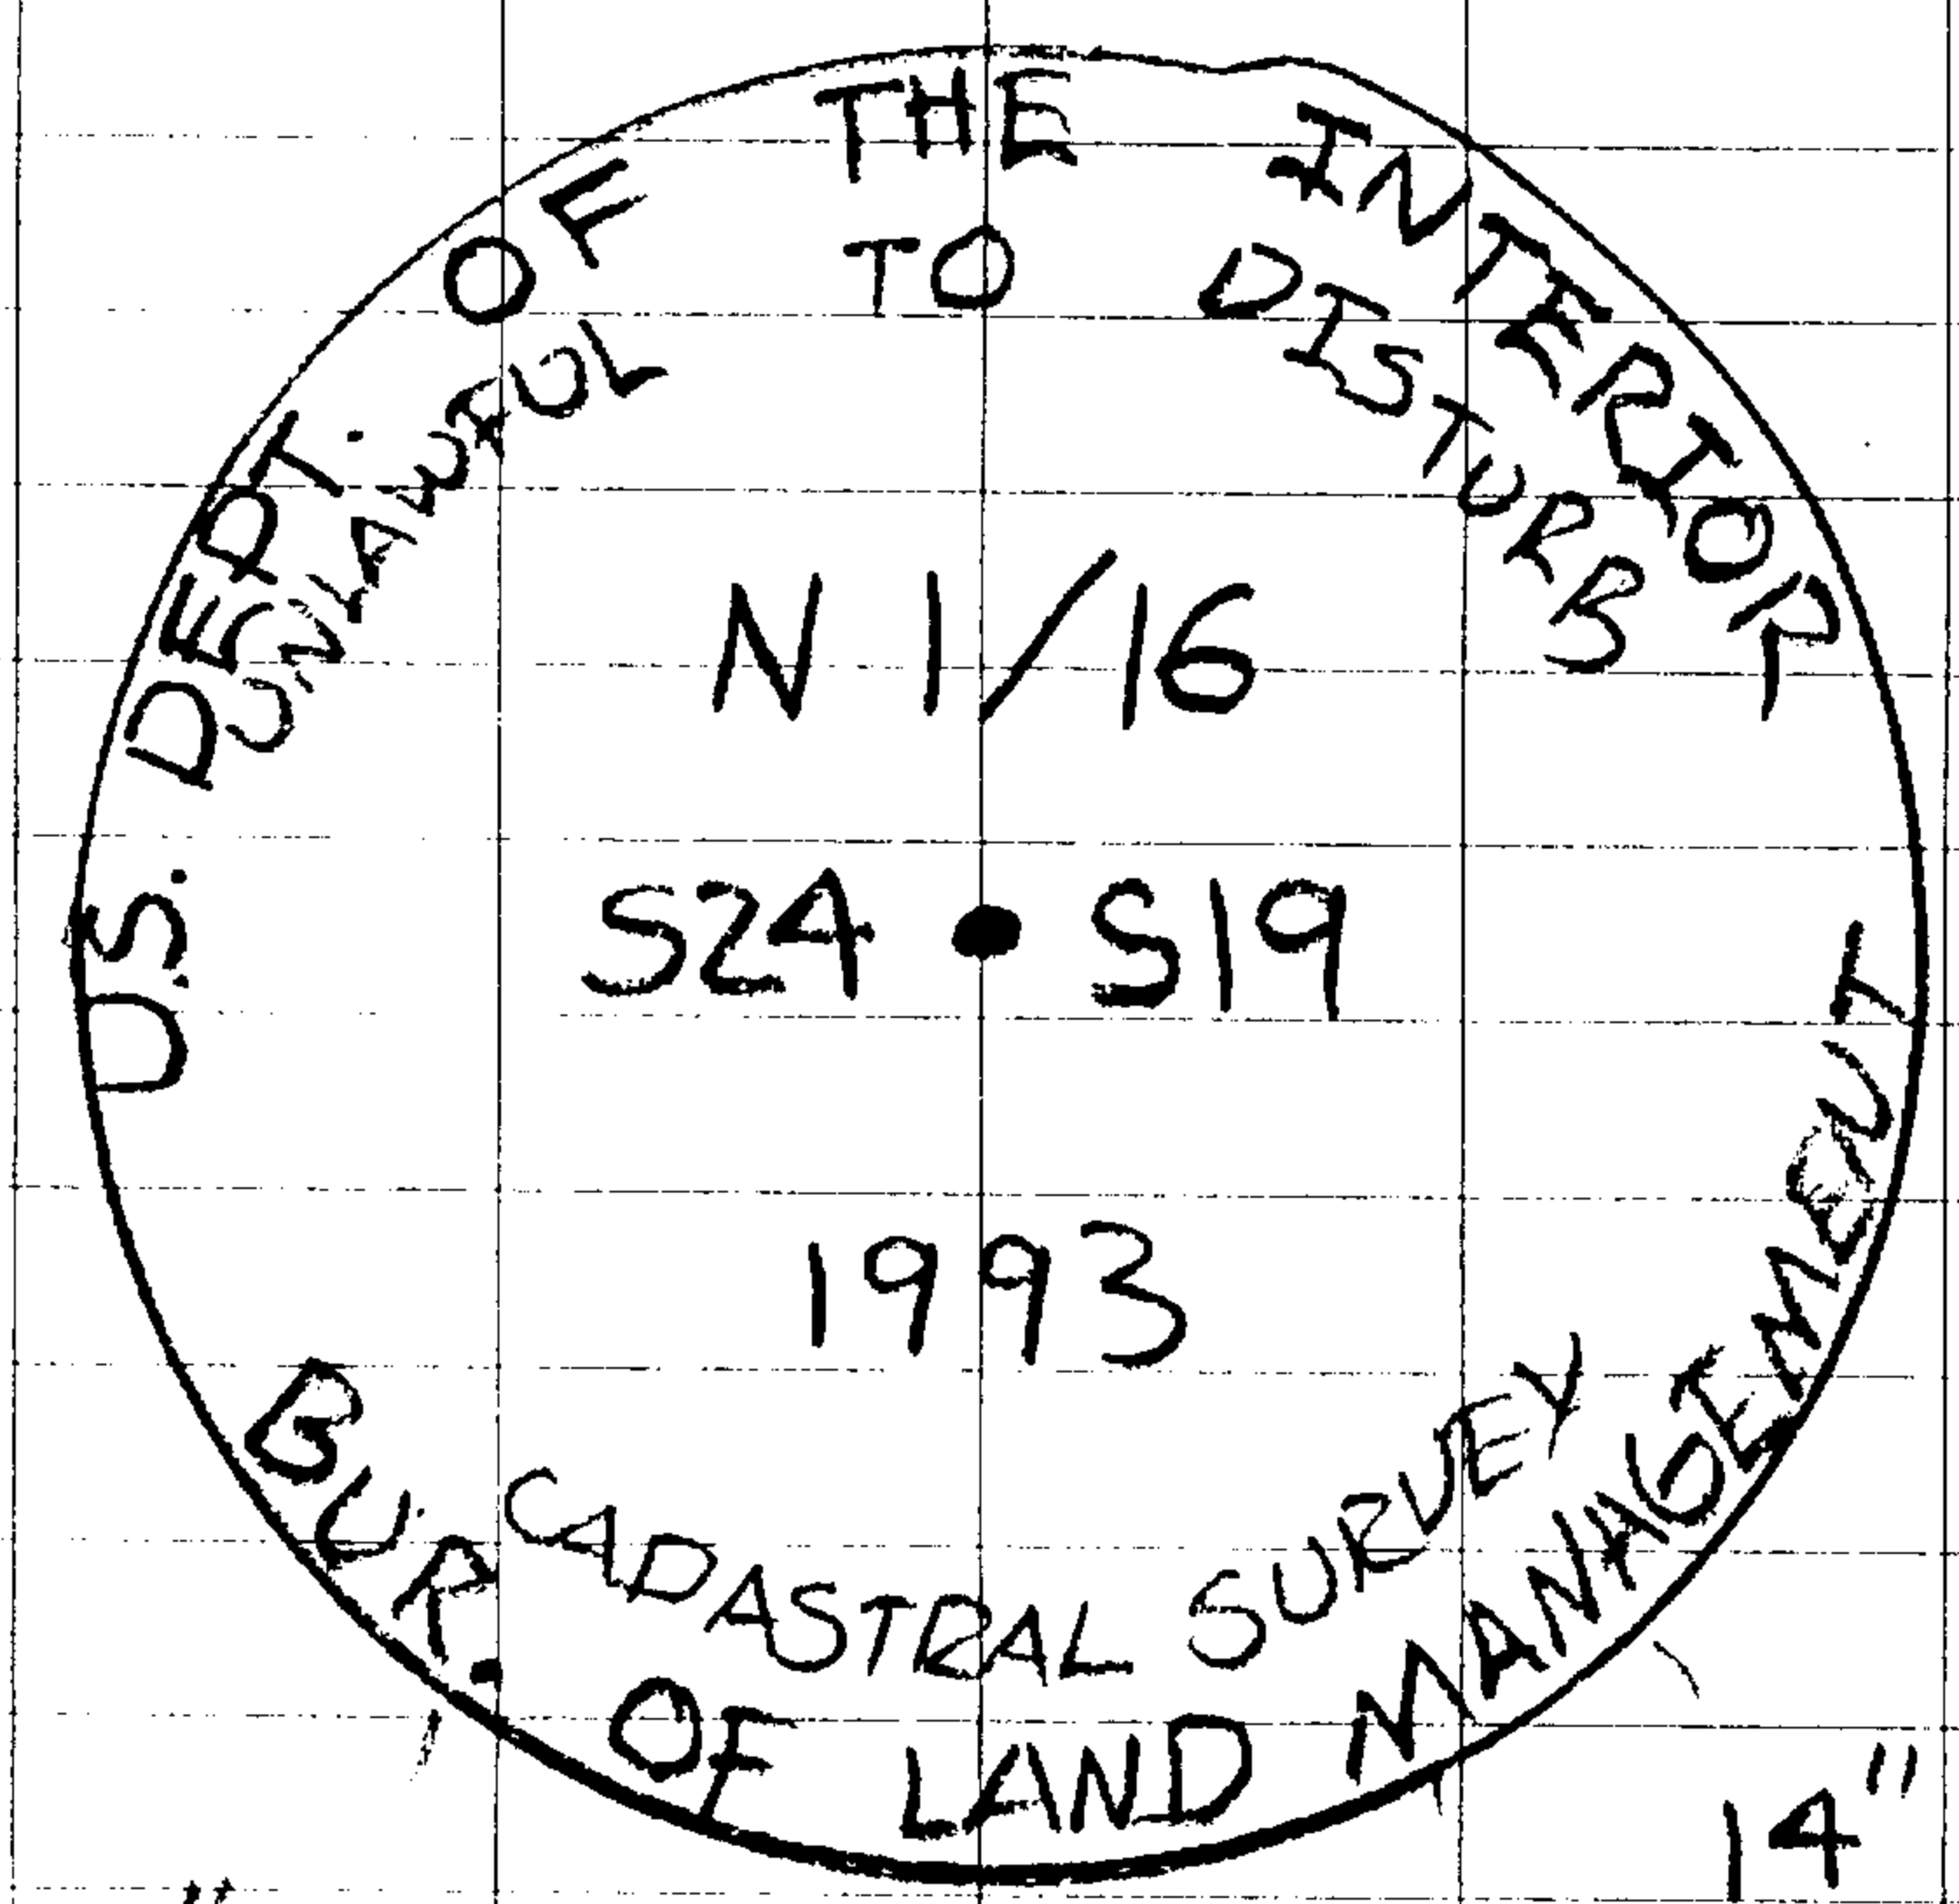

26" Hemlock
S36°W
33.7'

14" Fir
S45°E
17.5'

Rite in the Rain


Plum Creek
Standly Flat NW 1/16 S19

FILED

OCT 14 2014

"Found BT's"

9" Hemlock
N35°W
12.5'

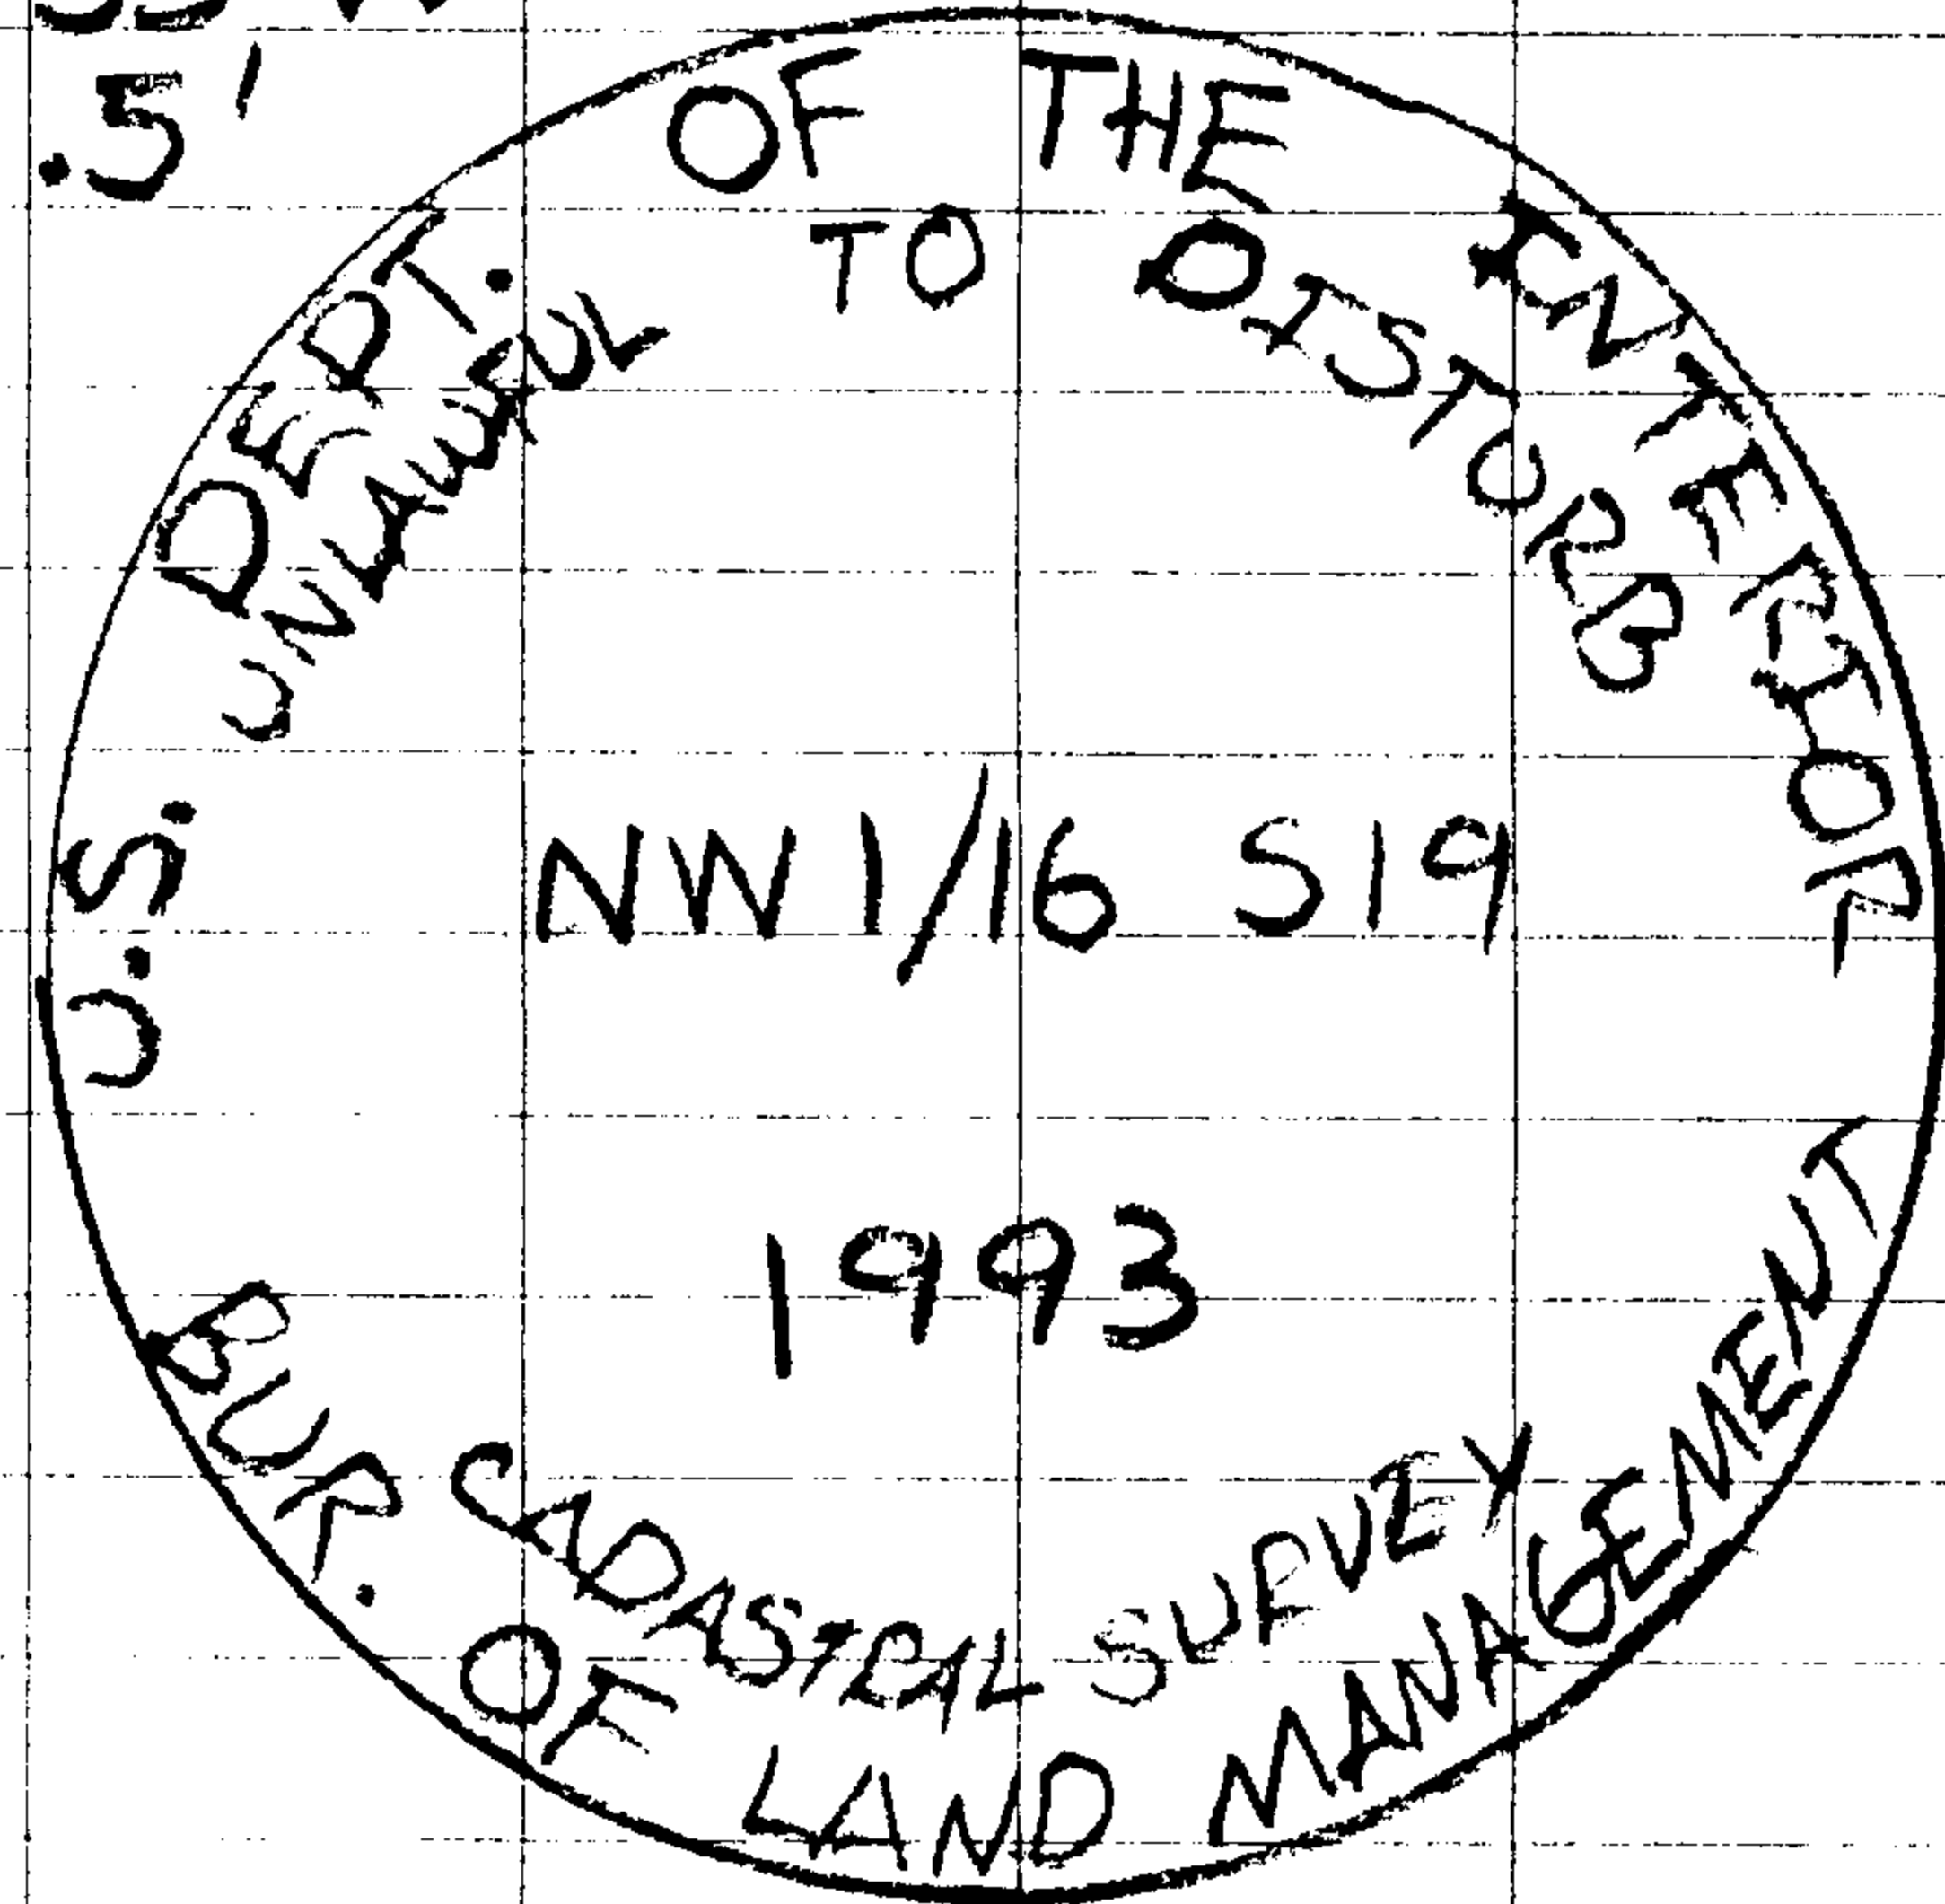

9" Hemlock
S46°E
31'
Healed Blaz

9" Hemlock
N35°W
12.5'
Healed Blaz

9" Hemlock
S46°E
31'

Rite in the Rain

BLM Lincnotes Pg 19568

140360 T31-9-19

C.S. File No 65/86-27C