

CORNER REPORT FORM

FILED

Section 28 Township 32S Range 8W
Douglas County Date 10-2014
PLSS Number 300240

Date: 10/15/2014 By: JC
This survey consists of:
Map: _____
Narrative: _____
Corner Rpt: CS 65/86-29

DOUGLAS COUNTY
SURVEYOR

CORNER DESIGNATION

1/4 COR S29/S28

- Condition report only
- Not Found
- Renewed
- Unrecorded
- Surveyed In
- Referenced out

Previous Renewals/Surveys, etc:

Thompson 1983 CS 58/275 M 95-33

Monument(s) & Accessories Found: (Condition and Source)

5/8" I. ROD
12" MADRONE S25E 12" Legible scribes
16" D. FIR N71W 41" GOOD SCAR

Monument Detail

Sketch

Monument Set (Procedures and Description)

New Accessories

A 6" FIR S28W 3 3/4 FT scribed 1/4 S29 BT
A 6" FIR N58E 15 FT scribed 1/4 S28 BT



Surveyor's Seal

Location & Comments

AREA BURNT
8/2013

Compass Declination 15 1/2
Firm/Agency: i.e. Engineering, Inc.
Address: 809 SE Pine St., Roseburg, OR 97470

Party Chief: N Fromdah
Notes:
Witness: D. MAURINS
R. OLSEN

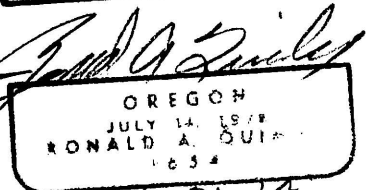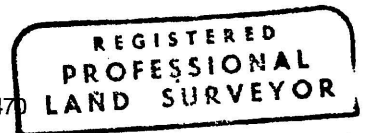

EXP 12-31-14

C.S. File CS 65/86-29