

FILED
Date: 10-28-2014 By: JC

This survey consists of:

Map: _____

Narrative: _____

Corner Rpt: C.S. 65/86-31

DOUGLAS COUNTY
SURVEYOR

CORNER REPORT FORM

Section 27 Township 22 S Range 8 W
Douglas County Date 10/17/2014
PLSS Number 420200

CORNER DESIGNATION

West 1/16 corner common to
Sections 27 and 34.

- Condition Report only
- Not Found
- Renewed
- Unrecorded
- Surveyed In
- Referenced out

Previous Renewals/Surveys, etc:

Set on 1962 B.L.M. resurvey. Pg 13ND

Monument(s) & Accessories Found: (Condition and Source)

Found 1962 B.L.M. Brass Cap.
Both B.L.M. B.T.'s are rotted stumps.

Monument Detail

Sketch

Standard B.L.M. Brass Capped iron pipe.

Monument Set (Procedures and Description)

N/A

New Accessories

A 14" diam. Fir scribed "W 1/16 S34 BT" bears S.19°E., 16.4 feet.
A 10" diam. Fir scribed "W 1/16 S27 BT" bears N.17°W., 8.6 feet.


Surveyor's Seal

Location & Comments

Compass Declination 15 1/2° East
Firm/Agency: David Edwards Land Surveying
Address: P.O. Box 361
Oakland, Oregon 97462
Party Chief: Brant Miller
Notes: _____
Witness: Eric Sprinkle



David A. Edwards

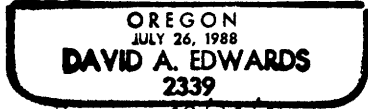

Renews 12/31/15

C.S. File 65/86-31