

FILED

Date: 11-14-2014 By: JC

This survey consists of:

Map: _____

Narrative: _____

Corner Rpt: CS 65/86-32

CORNER REPORT FORM

Section 16 Township 25S Range 1W
Douglas County Date 11/10/14
PLSS Number 340400

DOUGLAS COUNTY
SURVEYOR

CORNER DESIGNATION

1/4 corner common to
Sections 16 and 21

- ___ Condition Report only
- ___ Not Found
- X Renewed
- ___ Unrecorded
- ___ Surveyed In
- ___ Referenced out

Previous Renewals/Surveys, etc:

GLO survey by Johnson in 1900.
DCS renewal in 1966. Shown as found on M 20-2.

Monument(s) & Accessories Found: (Condition and Source)

Found 1966 DCS brass cap in good condition.
No bearing trees found.

Monument Detail

Sketch

Standard DCS brass capped iron pipe.

Monument Set (Procedures and Description)

N/A


New Accessories

An 11" diam. Fir scribed "1/4 S21 BT" bears S.58°E., 13.5 feet.
A 12" diam. Fir scribed "1/4 S16 BT" bears N.56°W., 4.1 feet.
A six foot steel post is set 2 feet East.

Surveyor's Seal

Location & Comments

Compass Declination 15 1/4° East
Firm/Agency: David Edwards Land Surveying
Address: P.O. Box 361
Oakland, OR. 97462
Party Chief: Brant Miller
Notes: _____
Witness: Eric Sprinkle

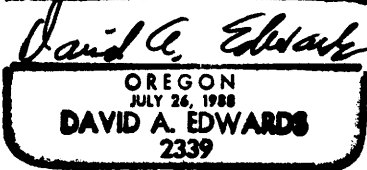

Renews 12/31/15

C.S. File 65/86-32