

FILED

Date: 1-20-2015 By: JC

This survey consists of:

Map: _____

Narrative: _____

Corner Rpt: C.S. 65/87-1

DOUGLAS COUNTY
SURVEYOR

CORNER REPORT FORM

Section 34 Township 22 S Range 7 W
Douglas County Date 1/5/15
PLSS Number 440200

CORNER DESIGNATION

1/4 corner common to
Sections 27 and 34

- ___ Condition Report only
- ___ Not Found
- X Renewed
- ___ Unrecorded
- ___ Surveyed In
- ___ Referenced out

Previous Renewals/Surveys, etc:

Orig. G.L.O. Byars 1871. Haines 1962 C.S. File 51/222: Set T-Iron.
D.C.S. 1962 report. B.L.M. 1984 resurvey. Set brass cap.

Monument(s) & Accessories Found: (Condition and Source)

Found 1984 B.L.M. brass cap good condition.
30" diam. Fir stump bears S.28°W., 35.6'.
13" diam. Fir with healed blaze bears N.53°W., 36.3'.
Rock outcrop not searched for.

Monument Detail

Sketch

Standard B.L.M. brass cap.

Monument Set (Procedures and Description)

N/A


New Accessories

A 24" diam. Fir bears N.84°E., 6.9 feet scribed "1/4 S27 BT"
No suitable trees available in Section 34.
A 6 foot steel post is set 2 feet West.

Surveyor's Seal

Location & Comments

Compass Declination 15° East
Firm/Agency: David Edwards Land Surveying
Address: P.O. Box 361
Oakland, OR. 97462
Party Chief: B. Miller
Notes: _____
Witness: E. Sprinkle

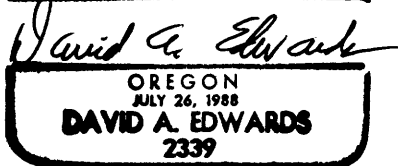

Renews 12/31/15

C.S. File 65/87-1