

FILED

Date: 1-27-2015 By: JC

This survey consists of:

Map: _____

Narrative: _____
Corner Rpt: CS 65/87-3

DOUGLAS COUNTY
SURVEYOR

CORNER REPORT FORM

Section 16 Township 29S Range 4 W
Douglas County Date 1/16/2015
PLSS Number 340500

CORNER DESIGNATION

1/4 corner common to
Sections 9 and 16

- ___ Condition Report only
- ___ Not Found
- X Renewed
- ___ Unrecorded
- ___ Surveyed In
- ___ Referenced out

Previous Renewals/Surveys, etc:

Original: Nathaniel Ford 1854. Several renewals. (see D.C.S. records)
BLM Resurvey in 1969 by James Jelley.

Monument(s) & Accessories Found: (Condition and Source)

1969 B.L.M. brass capped iron pipe.
30" diam. +/- Fir stump N.24°E. 245.5' Markham's Oak is gone.
40" diam. +/- Fir stump S.14°W., 58.1'
A 17" diam. Madrone with healed blaze bears N.53°W., 57.1'

Monument Detail

Sketch

Standard B.L.M. brass cap.

Monument Set (Procedures and Description)

N/A

New Accessories

A 9" diam. Fir scribed "1/4 S9 BT" bears N.27°E., 21.0'
No suitable trees within limits in Section 16.

Set 6 foot steel post 2 feet East

Surveyor's Seal

Location & Comments

Compass Declination 15° East

Firm/Agency: David Edwards Land Surveying


Address: P.O. Box 361

Oakland, Oregon 97462


Party Chief: B. Miller

Notes: _____

Witness: E. Sprinkle

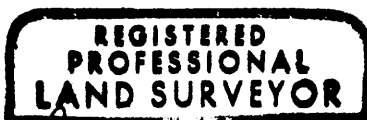

David A. Edwards

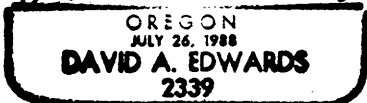

Renews 12/31/15.

C.S. File 65/87-3