

CORNER REPORT FORM

FILED

Section 29  
Douglas County  
PLSS Number  
200240

Township 32S Range 6W  
Date 1-2015

Date: 2-26-2015 By: DC  
This survey consists of:  
Map: \_\_\_\_\_  
Narrative: \_\_\_\_\_  
Corner Rpt: CS 65/87-5

DOUGLAS COUNTY  
SURVEYOR

CORNER DESIGNATION

1/4 COR 29/30

- Condition report only
- Not Found
- Renewed
- Unrecorded
- Surveyed In
- Referenced out

Previous Renewals/Surveys, etc:

PRICE CS 41/375 M 125-75 NIGREN 10/96  
M 24-1 PAULIN 1962 M 139-33 HOFFINE 2002

Monument(s) & Accessories Found: (Condition and Source)

Fd 1/4" IRON PIPE  
A 46" D. FIR N13E 21.1 6000 SCAR  
31" D. FIR STUMP S45W 12.5FT HONED SCAR

Monument Detail

Sketch

Monument Set (Procedures and Description)


New Accessories

A 1" FIR S79°E 22.7 FT Scribed 1/4 529 BT  
A 7" CHINGUM PIN N 14°W 5.2 FT. Scribed 1/4 530 BT

Surveyor's Seal

Location & Comments

Compass Declination 15 1/2  
Firm/Agency: i.e. Engineering, Inc.  
Address: 809 SE Pine St, Roseburg, OR 97470  
Party Chief: N. From Dahl  
Notes:  
Witness: R. OLSEN

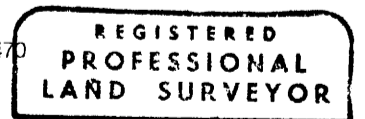

*Ronald A. Quimby*  
OREGON  
JULY 14, 1978  
RONALD A. QUIMBY  
1954

C.S. File EXP 12-31-16  
CS 65/87-5