

CORNER REPORT FORM

FILED

Section 29
Douglas County
PLSS Number
220260

Township 32S Range 6W
Date 1-2015

Date: 2/26/2015 By: X
This survey consists of:
Map: _____
Narrative: _____
Corner Rpt: CS 65/87-9
DOUGLAS COUNTY
SURVEYOR

CORNER DESIGNATION

N.W 1/4 529

- Condition report only
- Not Found
- Renewed
- Unrecorded
- Surveyed In
- Referenced out

Previous Renewals/Surveys, etc:

SET BY PRICE CS 41/375

Monument(s) & Accessories Found: (Condition and Source)

FD 1" I. PIPE
20" D. FIR N 70°E 62.7 FT GOOD SCAR
20" MARBONE S 4W 7.3 FT DOWN

Monument Detail

Sketch

Monument Set (Procedures and Description)

New Accessories



A 13" FIR S 36°E 9.0 FT scribed N.W 1/4 RT

Location & Comments

Surveyor's Seal

Compass Declination 15 1/2
Firm/Agency: i.e. Engineering, Inc.
Address: 809 SE Pine St., Roseburg, OR 97470

Party Chief: N. FROMDALL
Notes:
Witness: R. OLSEN

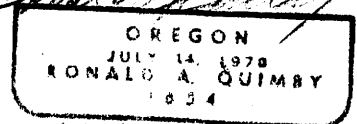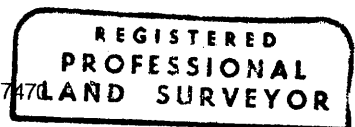

C.S. File 12-31-16
CS 65/87-9