

CORNER REPORT FORM

FILED

Section 29 Township 32S Range 6W  
Douglas County Date 1-2015  
PLSS Number 240260

Date: 2/26/2015 By: JC

This survey consists of:

Map: \_\_\_\_\_

Narrative: \_\_\_\_\_

Corner Rpt: CS65/87-12

DOUGLAS COUNTY  
SURVEYOR

CORNER DESIGNATION

CN 1/16 529

- Condition report only
- Not Found
- Renewed
- Unrecorded
- Surveyed In
- Referenced out

Previous Renewals/Surveys, etc:

SET BY PRICE CS 41/395

Monument(s) & Accessories Found: (Condition and Source)

FD 1" I. PIPE  
16" MADRONE S86°E 5.3 FT  
27" MADRONE S25W 10.6 FT GOOD SCAR

Monument Detail

Sketch

Monument Set (Procedures and Description)


New Accessories

Surveyor's Seal


Location & Comments

Compass Declination 15 1/2  
Firm/Agency: i.e. Engineering, Inc.  
Address: 809 SE Pine St., Roseburg, OR 97470

Party Chief: N. FROMDAHL  
Notes:  
Witness: R. OLSEN

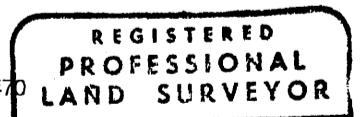

*[Handwritten Signature]*

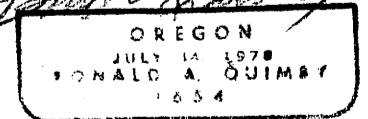

C.S. File MP 12-31-16  
CS 65/87-12