

CORNER REPORT FORM

FILED

Section 18  
Douglas County  
PLSS Number  
100460

Township 315 Range 8W  
Date 2-2015

Date: 2/26/2015 By: JC  
This survey consists of:  
Map: \_\_\_\_\_

Narrative: \_\_\_\_\_  
Corner Rpt: CS65/87-13  
DOUGLAS COUNTY  
SURVEYOR

CORNER DESIGNATION

SEC COR

R9W R8W  
13/18  
24/19

- Condition report only
- Not Found
- Renewed
- Unrecorded
- Surveyed In
- Referenced out

Previous Renewals/Surveys, etc:


BYARS 1900  
BLM Resurvey 1962  
WOODRUFF M. 155-17 2007  
WOODRUFF M 161-7 2010

Monument(s) & Accessories Found: (Condition and Source)

FD BLM BRASS CAP  
40" FIR STUMP N 30E 40.5 FT GOOD SCAR  
30" FIR N 64E 80 FT GOOD SCAR  
28" FIR SNAQ REMOVALS ONLY DOWN S 52E 26.6 FT  
8" FIR S 15W 14.6 FT GOOD SCAR  
26" FIR N 88W 66.2 FT GOOD SCAR

Monument Detail

Sketch

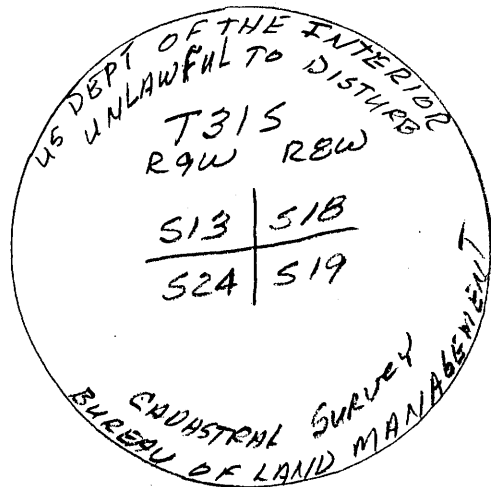

Monument Set (Procedures and Description)



New Accessories

Surveyor's Seal

Location & Comments

Compass Declination 15 1/2  
Firm/Agency: i.e. Engineering, Inc.  
Address: 809 SE Pine St., Roseburg, OR 97470

Party Chief: N FROMDAHL  
Notes:  
Witness: J LEONARD  
R. DISEN

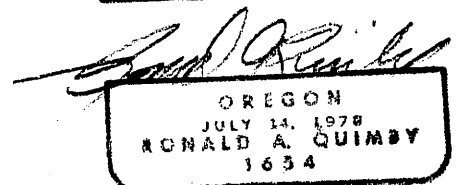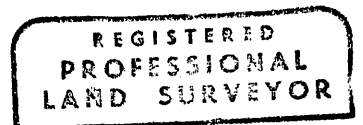

C.S. File EXP 12-31-16

CS65/87-13