

CORNER REPORT FORM

FILED

Section 18 Township 31S Range 8W  
Douglas County Date 2-2015  
PLSS Number 100440

Date: 2/24/2015 By: JC  
This survey consists of:  
Map: \_\_\_\_\_  
Narrative: \_\_\_\_\_  
Corner Rpt: CS 65/87-14  
DOUGLAS COUNTY SURVEYOR

CORNER DESIGNATION

1/4 SEC COR 13/18

- Condition report only
- Not Found
- Renewed
- Unrecorded
- Surveyed In
- Referenced out

Previous Renewals/Surveys, etc:

BYARS 1900 Vol 19 P 8241  
BLM RESURVEY 1962  
DCSO 1967 CS 54182  
C. WOODRUFF 2008-11156-5 & 2010 11161-7


Monument(s) & Accessories Found: (Condition and Source)

FD BLM BRASS CAP  
35" FIR SWAG, N50E 12.0 FT (Rotted)  
26" FIR N77E 18.8 FT GOOD SCAR

Monument Detail

Sketch

Monument Set (Procedures and Description)

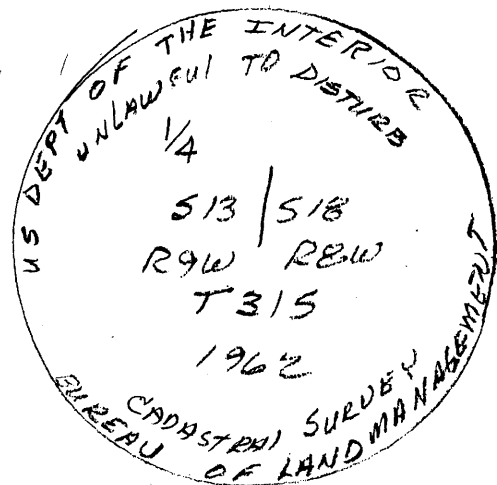

New Accessories

12" FIR N35W 15.8 FT SCRIBED 1/4 513 BT  
6" FIR S36W 24.5 FT " " " "  
16" FIR S15W 37.2 FT " " " "

Surveyor's Seal

Clear cut unit To the East

Location & Comments

CORNER IS ON WEST OF  
NEW CLEAR CUT UNIT  
APPROX 200' EAST OF  
RD # 31-B-31 AND APPROX  
200' NORTH OF LOGGING  
SPUR TO CLEAR CUT #  
RD # 9-13

Compass Declination 15E  
Firm/Agency: i.e. Engineering, Inc.  
Address: 809 SE Pine St., Roseburg, OR 97470

Party Chief: N FROMDALL  
Notes:  
Witness: R. OLSEN

REGISTERED PROFESSIONAL LAND SURVEYOR

*Ronald A. Quimby*

OREGON  
JULY 14, 1978  
RONALD A. QUIMBY  
1634

C.S. File EXP 12-31-16

CS 65/87-14