

OREGON CORNER RESTORATION FORM

TOWNSHIP 30 RANGE 10/09

Corner Designation

R10W R9W
T30S
S1 | S6

Condition Report Only
 Not Found
 Renewed
 Unrecorded
 Surveyed in
 Referenced Out

Previous Renewals / Surveys, etc.

Hostetter, 2013 (C.S. 40-A-38); Geisler, 1984 (Douglas County notes; M97-9); Shaner, 1963 (PB7, Pg. 23; Book 12, Pg. 02; Book 10, Pg. 315); Bushey, 1893 (G41, Pg. 46, 47); Hathorn, 1855 (G41, Pg. 01; Douglas County notes).

Monument(s) & Accessories Found: (Condition and Source)

We find a 2½" aluminum cap on a 7/8" iron pipe, per Geisler, 1984 (Douglas County notes; M97-9); 16" White Cedar stump, N34°E-61.20'; 8" Hemlock stump, N79°W-54.32'; 17" Douglas Fir, N77°30'E-16.60'; 14" Douglas Fir, S37°30'W-12.86'; 15" Douglas Fir, N66°30'W-5.28'; 12" Douglas Fir, N14°E-9.67'.

Monument Detail


Sketch

Monument Set

NONE

New Accessories

NONE

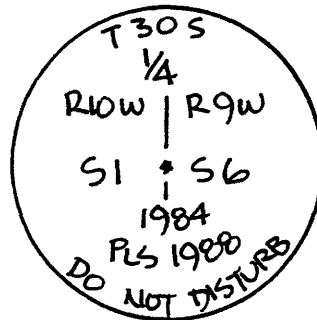

Locations & Comments

Compass Declination 17°E
Firm/Agency Coos County Surveyor
Address Coos County Courthouse
250 N. Baxter
Coquille, OR 97423
Party Chief: Matthew Martin
Notes: Matthew Martin
Crew: Bill Hales

Date: November 18, 2014

FILED

Date: 3-9-2015 By: JC
This survey consists of:
Map: _____
Narrative: _____
Corner Rpt: CS 65/87-19

DOUGLAS COUNTY
SURVEYOR

