

OREGON CORNER RESTORATION FORM

TOWNSHIP 28/29 RANGE 09/08

Corner Designation

T28S
R9W R8W
S25 S30
S36 S31
R9W R8W
T29S

Condition Report Only
 Not Found
 Renewed
 Unrecorded
 Surveyed in
 Referenced Out

Previous Renewals / Surveys, etc.

Stuntzner, 1972 (Book 11, Pg.400; C.S. 26-A-48); Jelley, 1964 (G27, Pg. X7);
Egerman, 1960 (Book 10, Pg. 300); Glenn, 1959 (G27, Pg.64); Hathorn, 1875
(G27, Pg. 003).

Monument(s) & Accessories Found: (Condition and Source)

We find a 3/4" brass cap on a 2 1/2" iron pipe, per Glenn, 1959 (G27, Pg. 64);
23" Grand Fir, N25°30'E-33.47'; 23" Incense Cedar, N57°30'W-34.82'; 19"
Douglas Fir, S22°E-27.87'; 22" Incense Cedar, S61°W-12.09'; The remaining BTs of
record have been reduced to piles of duff.

Monument Detail

Sketch


Monument Set

NONE

New Accessories

NONE

Locations & Comments

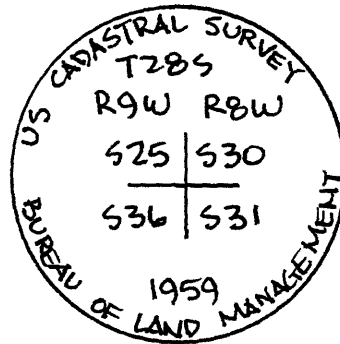

Compass Declination 17°E
Firm/Agency Coos County Surveyor
Address Coos County Courthouse
250 N. Baxter
Coquille, OR 97423
Party Chief: Matthew Martin
Notes: Matthew Martin
Crew: Bill Hales
Michael L. Dado

Date: December 3, 2014

FILED

Date: 3-9-2015 By: Jc

This survey consists of:

Map: _____

Narrative: _____

Corner Ref: CS 65/87-21



DOUGLAS COUNTY
SURVEYOR

C.S. File No 65/87-21

100200