

OREGON CORNER RESTORATION FORM

TOWNSHIP 28 RANGE 09/08

Corner Designation

R9W R8W
T28S

S24 S19

Condition Report Only
 Not Found
 Renewed
 Unrecorded
 Surveyed in
 Referenced Out

Previous Renewals / Surveys, etc.

Mulkins, 1994 (Book 20, Pg. 242; C.S. 26-B-68); Safstrom, 1962 (Book 10, Pg. 60); Hathorn, 1855 (G27, Pg. 002).

Monument(s) & Accessories Found: (Condition and Source)

We find an 1½" iron pipe, 8" tall, painted blue, in fire trail, per Safstrom, 1962 (Book 10, Pg. 60); 16" Douglas Fir, N17°30'E-28.76'; 10" Chinkapin, East-10.67'; 18" Douglas Fir tall stump, 6' tall, S16°W-17.00'; 18" Douglas Fir tall stump, 6' tall, S69°W-21.84'. We set a Yew wood post 2' South and painted the top in blue.

Monument Detail

Sketch

Monument Set

NONE

New Accessories

NONE


Locations & Comments

Compass Declination 17°E
Firm/Agency Coos County Surveyor
Address Coos County Courthouse
250 N. Baxter
Coquille, OR 97423
Party Chief: Matthew Martin
Notes: Matthew Martin
Crew: Bill Hales
Michael L. Dado

Date: December 4, 2014

FILED

Date: 3-9-2015 By: JC
This survey consists of:
Map: _____
Narrative: _____
Corner Rpt: CSC65/87-22

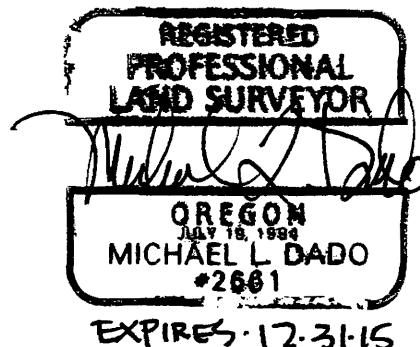

DOUGLAS COUNTY
SURVEYOR

C.S. File No 65/87-22