

OREGON CORNER RESTORATION FORM

TOWNSHIP 28/29 RANGE 09

Corner Designation

T28S R9W

S34
S3

T29S R9W

- Condition Report Only
- Not Found
- Renewed
- Unrecorded
- Surveyed in
- Referenced Out

Previous Renewals / Surveys, etc.

Byron, 1963 (Book 11, Pg. 377; Douglas County C.S. file 49/100); Chapman, 1875 (G27, Pg. 011).

Monument(s) & Accessories Found: (Condition and Source)

We find a 2½" brass cap on a 1¼" iron pipe, 0.8' tall, in good condition and solid in a mound of rocks per Byron, 1963 (Book 11, Pg. 377); White Cedar post 2' North of BCIP; 31" Douglas Fir stump, N09°30'W-18.34'; 12" Douglas Fir, N43°30'E-13.68'; 19" Douglas Fir, S73°W-12.47'; 15" Douglas Fir, N65°30'W-14.26'.

Monument Detail

Sketch


Monument Set

NONE

New Accessories

NONE

Locations & Comments

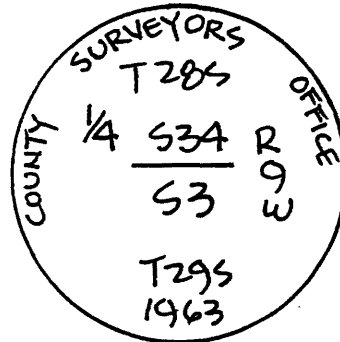

Compass Declination 17°E
 Firm/Agency Coos County Surveyor
 Address Coos County Courthouse
250 N. Baxter
Coquille, OR 97423
 Party Chief: Matthew Martin
 Notes: Matthew Martin
 Crew: Bill Hales

Date: January 20, 2015

FILED

Date: 3-9-2015 By: JC

This survey consists of:

Map: _____

Narrative: _____

Corner Rpt: CS 65/87-23

DOUGLAS COUNTY
SURVEYOR



C.S. File No 65/87-23