

Book 27, Page 223

T28S R9W
S36
S1
T29S R9W

Warren Knight Staff Compass - declination 17°E

proportioned in 1959

December 2, 2014

OLD MONUMENT Glenn 1959 G27, Pg.060
Found 3 1/4" brass cap, on a 2 1/2" iron pipe, buried 0.9' deep, leans slightly to the South, in good condition and solid in the ground. Note: We find a 1" iron pipe, 0.1' South. The cap is oriented N12°E. Monument falls on the SE edge of an old cat road running NE/SW. Steel fence post and sign stands 3' East of BCIP.

OLD BT Glenn 1959 G27, Pg.060
Found hole in ground with Grand Fir bark around hole, N26°W, 23.43' to center. Found tag on ground.

OLD BT Ladig & Chensy 1976 Book 12, Pg.216
Found 19" Grand Fir, S10°E, 25.15' to right side center. We find a healed blaze and a Douglas County tag in place. We paint the face and a band around the tree in blue.
GOOD CONDITION


OLD BT Hoffine 1999 M133-59
Found 20" Grand Fir stump, N78°W, 17.66' to spike at left side center. We chop an "X" in the stump, paint the "X" in blue and place a yellow Coos County tag. **FAIR CONDITION**

Note: These existing BTs have aluminum nails in the face and side centers, but no other marks.

NEW BT
A 12" Douglas Fir, S62°W, 25.60' to a spike at right side center. We blaze and scribe "1/4 S1 BT". We paint the blaze, scribes and a band around the tree in blue and attach a yellow Coos County tag.

NEW BT
A 9" Douglas Fir stump, 3' tall, N72°E, 15.69' to a spike at right side center. We chop an "X" in the face. We paint the "X" and the top of the stump in blue and attach a yellow Coos County tag.

Present:
Matthew Martin
Bill Hales

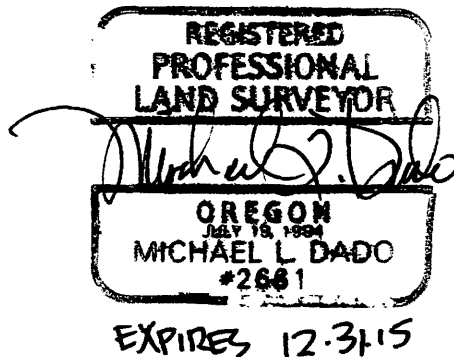

FILED

Date: 3-9-2015 By: Jc
This survey consists of:
Map: _____
Narrative: _____
Corner Rpt: C.S. 65/87-24

DOUGLAS COUNTY
SURVEYOR

C.S. File No 65/87-24