

Book 27, Page 225

T28S
S25 | S30
R9W | R8W

Warren Knight Staff Compass - declination 17°E

proportioned in 1959

December 8, 2014

OLD MONUMENT

Glenn 1959

G27, Pg.65

Found 3/4" brass cap, on a 2 1/2" iron pipe, 0.4' tall, in good condition and solid in the ground. We find a steel fence post 2' North.

OLD BT

Glenn 1959

G27, Pg.65

Found 33" Hemlock, N44°W, 22.00' (N39°30'W-23.1' rec.) to right side center. We find a healed blaze and a BLM tag in place. We paint the face and a band around the tree in blue. GOOD CONDITION

OLD BT

Shaner 1993

Douglas Co. 63-153

Found 11" Grand Fir, dead snag, N85°W, 48.00' (N80°W-47.3' rec.) to right side center. We find visible scribes in a chain saw blaze and a 1993 BLM tag in place. We paint the blaze, face and a band around the tree in blue. FAIR CONDITION

OLD BT

Shaner 1993

Douglas Co. 63-153

Found 35" Grand Fir, S11°30'W, 1.8' to face, 3.5, to right side center (S1°E-2.3' rec.). We find a healed blaze with 2 BLM tags in place. We paint the face and a band around the tree in blue. GOOD CONDITION

OLD BT

Shaner 1993

Douglas Co. 63-153


Found 32" Hemlock, tall stump, 5' tall, S32°30'E, 41.00' (S28°E-40.2' rec.) to heart center. We find visible scribes in a chain saw blaze and a BLM tag in place. We paint the blaze, face and a band around the stump in blue. GOOD CONDITION

NEW BO

A 44" Red Cedar stump, N11°E, 14.98' to a spike w/Coos County washer driven (offcenter) into the top. We chop an "X" into the face. We paint the "X" in blue and attach a yellow Coos County tag.

Present:

Matthew Martin
Bill Hales
Michael L. Dado

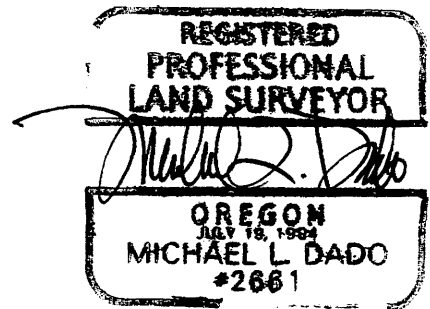

FILED

Date: 3-9-2015 By: JC

This survey consists of:

Map: _____

Narrative: _____

Corner Rpt: CS 65/87-25

DOUGLAS COUNTY
SURVEYOR

C.S. File No 65/87-25