

Book 27, Page 226

T28S
S13 | S18
R9W | R8W

Warren Knight Staff Compass - declination 17°E

proportioned in 1976

December 16, 2014

OLD MONUMENT

McDowell 1976

C.S. 26-A-59

Found 3 1/4" brass cap, on a 2 1/2" stainless steel pipe, 0.7' tall, in good condition and solid in the ground. We find a pitch post 3' North. Location Help: There is a 14" barely live Yew tree with a large chopped out face, N5°W-16'.

OLD BT

McDowell 1976

C.S. 26-A-59

Found 24" Hemlock tall stump, 6' tall, N56°E, 28.35' to top center. We find a healed blaze and both a BLM tag and a Weyco. tag in place. We paint the face in blue. POOR CONDITION

OLD BT

McDowell 1976

C.S. 26-A-59

Found 9" dead Yew tree, N41°W, 15.24' to left side center. We find visible scribes, a Weyco nail in the face and both a BLM tag and a Weyco. tag in place. We paint the face in blue. Tree leans to the East, being held up by another Yew tree. POOR CONDITION

OLD BT

Graham 2002

G68, Pg. 223

Found 10" Douglas Fir, S78°W, 16.37' to right side center. We find a healed blaze and a BLM tag in place. We paint the face and a band around the tree in blue. GOOD CONDITION

OLD BT

Graham 2002

G68, Pg. 223

Found 11" Hemlock, N41°E, 21.21' to right side center. We find visible scribes in an open blaze and a BLM tag in place. We paint the face and a band around the tree in blue. GOOD CONDITION

NEW BT

An 8" Douglas Fir, N85°E, 19.80' to a nail at left side center. We blaze and scribe "1/4 S18 BT". We paint the blaze, scribes and a band around the tree in blue and attach a yellow Coos County tag.

NEW BT

A 19" Hemlock, N41°W, 16.79' to a nail at right side center. We bark scribe "1/4 S13 BT". We paint the scribes and a band around the tree in blue and attach a yellow Coos County tag.

Present:

Matthew Martin

Bill Hales

FILED

Date: 3-9-2015 By: JC


This survey consists of:

Map: _____

Narrative: _____

Corner File: 65/87-26

DOUGLAS COUNTY
SURVEYOR

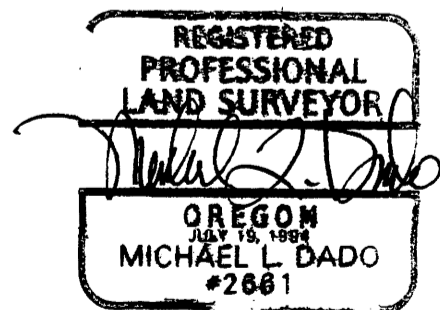

EXPIRES 12-31-15

C.S. File No 65/87-26