

Book 27, Page 229

T27S
S36 | S31
R9W R8W

Warren Knight Staff Compass - declination 17°E

proportioned in 1997

January 22, 2015

OLD MONUMENT Mulkins 1997 C.S. 22-A-185
Found 2" aluminum cap, on a 5/8" iron rod, 0.6' tall, in good condition and solid in the ground. We find the original line tree still in position, now a 30" stump, 6' tall (36" Douglas Fir stump, 6' tall, S0°45'48"E-132.67' rec.). Location help: 8" and 6" twin Hemlock snags N45°W-1.17' to face.

OLD BT Mulkins 1997 C.S. 22-A-185
Found 12" Douglas Fir, N10°E, 23.22' to found nail at left side center. We find a healed blaze and a Mulkins tag in place. We paint the face and a band around the tree in blue.
GOOD CONDITION


OLD BT Mulkins 1997 C.S. 22-A-185
Found 8" dead Hemlock stub, S88°E, 4.30' to found nail at left side center. We find a healed blaze and a Mulkins tag in place. We paint the face and a band around the tree in blue.
FAIR CONDITION

OLD BT Mulkins 1997 C.S. 22-A-185
Found 16" Douglas Fir high stump, 6' tall, S28°30'W, 8.88' to found nail at right side center. We find a healed blaze and a Mulkins tag in place. We paint the face and a band around the stump in blue. **GOOD CONDITION**

OLD BT Mulkins 1997 C.S. 22-A-185
Found 15" Douglas Fir high stump, 5.5' tall, S05°E, 47.51' to found nail at left side center. We find a healed blaze and a Mulkins tag in place. We paint the face and a band around the stump in blue. **GOOD CONDITION**

NEW BT
A 17" Douglas Fir, S14°E, 36.82' to a nail at right side center. We blaze and scribe "1/4 S31 BT". We paint the blaze, scribes and a band around the tree in blue and attach a yellow Coos County tag. A 20" wind thrown Douglas Fir is down on line to both SE B.T.s. Both SE trees were blazed to previous erroneous monument.

Present:
Matthew Martin
Bill Hales

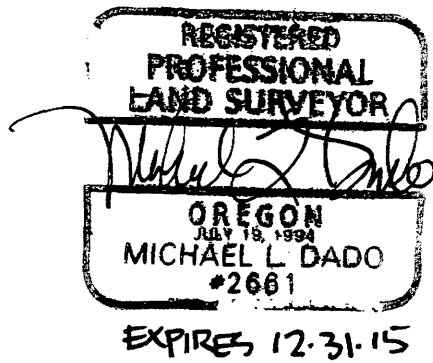

FILED
Date: 3-9-2015 By: X
This survey consists of:
Map: _____
Narrative: _____
Corner Rpt. CS 65/87-27

DOUGLAS COUNTY SURVEYOR

C.S. File No 65/87-27

100140