

BT6  
COUNTY SURVEYOR'S RECORD  
OF  
RE-ESTABLISHED GOVERNMENT CORNERS

Decl. Compass 17° E Mo. December 23 Day 2014 Year No. Book Page

Old Monument Glenn 1959 G27, Pg. 63  
Found 3/4" brass cap on a 2 1/2" iron pipe, 0.4" tall, in good condition and solid in the ground. There is a ring of sand stone rocks placed around this monument. We set a Douglas Fir post 3' North and paint the top in blue.

Old Monument found by Byron 1957 Book 12, Pg. 13  
Found an 8" hub on a 1" axle, 1.0' tall, in good condition and solid in the ground, driven in on the North side of the BCIP. Byron thinks this axle was set by the Coos County Surveyor, but we are unable to find any record of this.

Old BT Hathorn 1855 G27, Pg. 004  
Found a 42" Douglas Fir rotted and burned 1/2 shell, N85°E, 8.34' (S80°E var.) to center of bark ring. We find no visible marks. We paint the top in blue.  
POOR CONDITION


Old BT Byron 1957 Book 12, Pg. 13  
Found a 17" Red Cedar snag, S41°E, 43.72' to left side center. We find visible scribes and a 1959 BLM tag in place. We paint the face and a band around the snag in blue. POOR CONDITION

Old BT Byron 1957 Book 12, Pg. 13  
Found a 14" Grand Fir stump, S61°W, 24.21' to right side center. We find no marks, but there is a BLM tag in place. We paint "BT" on the stump in blue. POOR CONDITION

New BT  
A 5" Douglas Fir, S71°30'W, 29.52' to a nail at left side center. We blaze and scribe "BT" low and an "X" high. We paint the blaze, scribes and "X" in blue and attach a yellow Coos County tag.

New BT  
A 34" Grand Fir, N55°30'E, 37.02' to a nail at left side center. We bark scribe "1/4 S31 BT." We paint the scribes and a band around the tree in blue and attach a yellow Coos County tag.

Present:  
Matthew Martin  
Bill Hales

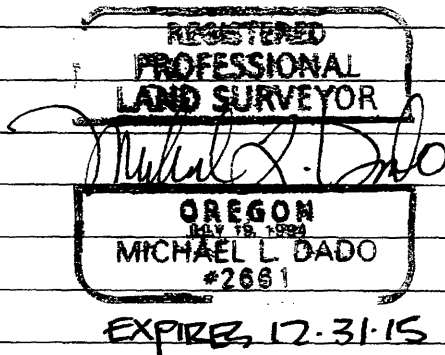

FILED  
Date: 3/9/2015 By: JC  
This survey consists of:  
Map: \_\_\_\_\_  
Narrative: \_\_\_\_\_  
Corner Fpt: CS 65/87-30

DOUGLAS COUNTY  
SURVEYOR