

BT6
COUNTY SURVEYOR'S RECORD
OF
RE-ESTABLISHED GOVERNMENT CORNERS

419

Decl. Compass 17° Mo. January 8 Day 2015 Year No. Book Page

Old Monument Gawron 1962 G 27, Pg. 49
Found $3\frac{1}{4}$ " brass cap on a $2\frac{1}{2}$ " iron pipe, 0.3' tall, in good condition and solid in the ground. Monument falls 50' North of Weaver Ridge Road.


Old BT Gawron 1962 G 27, Pg. 49
Found a 32" Hemlock stump, 3' tall, $N79^{\circ}E$, 44.16' ($N78^{\circ}E - 44.55'$ vac) to heart center. We find a healed blaze and 2 BLM tags in place. We paint the face and a ring around the top in blue. Stump has been used as a tail hold for logging. FAIR CONDITION

Old BT Gawron 1962 G 27, Pg. 49
Found a 32" broom top Red Cedar, $S86^{\circ}W$, 13.35' ($S83^{\circ}E - 13.86'$ vac) to right side center. We find a healed blaze and BLM(2) tags in place. We paint the face and a ring around the tree in blue. There are 3 line blazes on the North side of this tree. GOOD CONDITION

New BT
A 16" Douglas Fir, $S15^{\circ}W$, 11.11' to a nail at left side center. We blaze and scribe " $\frac{1}{4}$ S5 BT." We paint the blaze, scribes and a band around the tree in blue and attach a yellow Coos County tag.

New BO
A 13" Douglas Fir stump, 1' tall, $N32^{\circ}W$, 5.10' to a spike and Coos County steel washer driven in at heart center. We chop a flat spot on the face of the stump, paint the face and a ring around the top of the stump in blue and attach a yellow Coos County tag.

Present:
Matthew Martin
Michael L. Dado

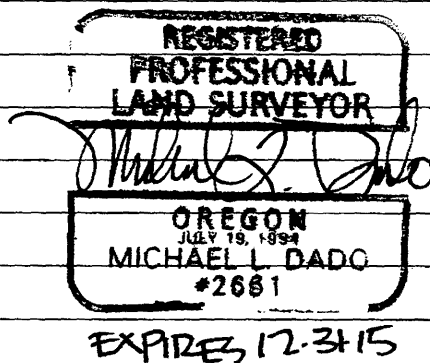

FILED

Date: 3-9-2015 By: JC
This survey consists of:
Map: _____
Narrative: _____
Corner Rpt: Cs 65/87-31

DOUGLAS COUNTY
SURVEYOR

240700

C.S. File No 65/87-31