

T285 R9W
420 $\frac{33}{4}$
T295 R9W

BT6
COUNTY SURVEYOR'S RECORD
OF
RE-ESTABLISHED GOVERNMENT CORNERS

Decl. Compass 17° E Mo. January 12 Day 2015 Year No. Book Page

Old Monument Stephens 1964 Book 10, Pg. 308

Found old and rusty 3/4" iron pipe, 0.3' tall, in good condition and solid in the ground. We set a Red Cedar stake 3' North and paint the top in blue.

Old BT Chapman 1875 G 27, Pg. 011

Found an 80" hollow Red Cedar stump, S61°E, 3.75' (S43°E-3.3'; 7.5' inc.) to BLM tag on face. We find a chopped out hole, no visible marks and a G.P. back tag in place. We paint the face and "BT" in blue. Stump has been used as a tail hold for logging. FAIR CONDITION

Old BT Chapman 1875 G 27, Pg. 011

Found a 48" Red Cedar, N71°W, 18.42' to right side center. We find a chopped out hole to an exposed flat face with no visible marks and a BLM tag in place. We paint the face and "BT" in blue. GOOD

New BT

An 11" Douglas Fir, N04°30'W, 6.44' to a nail at right side center. We blaze and scribe "1/4 S33 BT." We paint the blaze, scribes and a band around the tree in blue and attach a yellow Coos County tag.

New BT


A 14" Hemlock, S42°W, 46.13' to a nail at right side center. We bark scribe "1/4 S4 BT." We paint the scribes and a band around the tree in blue and attach a yellow Coos County tag.

Present:

Matthew Martin

Bill Hales

Michael L. Dado

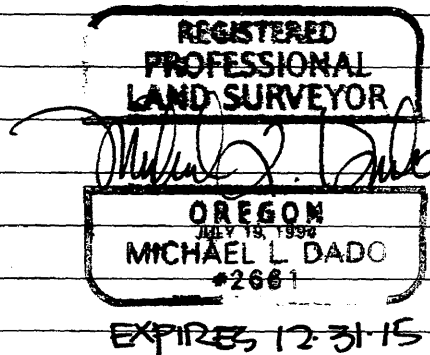

FILED

Date: 3-9-2015 By: JC

This survey consists of:

Map: _____

Narrative: _____

Corner Rpt. CS 65 187-32

DOUGLAS COUNTY
SURVEYOR

C.S. File No 65/87-32

340700