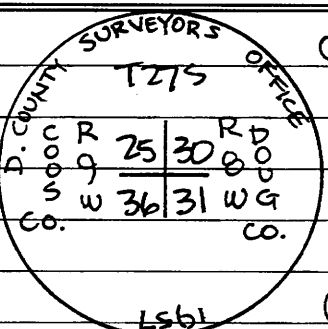
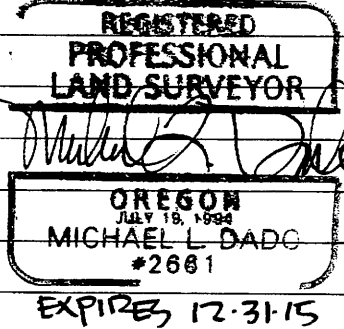


BT6
COUNTY SURVEYOR'S RECORD
 OF
RE-ESTABLISHED GOVERNMENT CORNERS

Decl.	Mo.	Day	Year	No.	Book	Page	
		Old Monument	Byron 1957	Douglas County	49-5		
		Found 2 1/2" brass cap on a 1" o.d. iron pipe, 0.9' tall, in good condition and solid in the ground, slight lean to the South. We set a Cedar post 2' North and paint the top in blue.					
		Old BT	Haydon 1896	G.21, Pg. 2			
		Found a 30" Red Cedar tall stump, 7' tall, N18°W, 28.42' to left side center. Stump has a chopped out healed blaze with no visible marks. There is an axe hole high with a BLM tag and a Coos Bay Lumber back tag in place. We chop a new "X" and paint the "X" and the face in blue. GOOD CONDITION					
		Old BT	Byron 1957	Douglas County	49-5		
		Found a 42" White Cedar stump, S35°W, 52.45' to heart center. Approx. 1/3 of the stump is gone. We find no visible marks. We paint "BT" in blue. POOR					
		Old BT	Bowder 1976	G55, Pg. 190			
		Found a 20" Douglas Fir tall stump, 6' tall, S70°W, 45.38' to right side center. We find a healed blaze and a BLM tag in place. We paint the face in blue. POOR					
		Old BT	Bowder 1976	G55, Pg. 190			
		Found a 17" Douglas Fir tall stump, 6' tall, N48°30'W, 56.54' to right side center. We find a healed blaze and a BLM tag in place. We paint the face in blue. POOR					
	Old BT	Bowder 1976	G55, Pg. 190				
	Found a 26" Douglas Fir, N06°30'E, 9.98' to left side center. We find a healed blaze and a BLM tag in place. We paint the face and a band around the tree in blue. GOOD						
	New BT	A 15" Douglas Fir, S63°E, 20.32' to a nail at right side center. We blaze and scribe "T27 R8 S31 BT". We paint the blaze, scribes and a band around the tree in blue and attach a new yellow tag (Coos County).					
	New BT	A 5" Douglas Fir, S66°W, 21.37' to a nail at right side center. We blaze and scribe "BT" low and "X" high. We paint the blaze, scribes, "X" and a band around the tree in blue and attach a yellow Coos County tag.					
	New BT	A 5" Douglas Fir, N43°30'W, 30.60' to a nail at left side center. We blaze and scribe "BT" low and "X" high. We paint the blaze, scribes, "X" and a band around the tree in blue and attach a yellow Coos County tag.					
Present:							
Matthew Martin							
Bill Hales							
FILED							
Date: 3-9-2015 By: JC							
This survey consists of:							
Map:							
Narrative:							
Corner Rpt: CS65/87-33							
							
DOUGLAS COUNTY SURVEYOR							
C.S. FILE 65/87-33							