

BT6
COUNTY SURVEYOR'S RECORD
 OF
RE-ESTABLISHED GOVERNMENT CORNERS

Decl. Compass 17°E Mo. February 10 Day 2015 Year No. Book Page

Old Monument Boulder 1978 G34, Pg. 3A
 Found 3/4" brass cap on a 2 1/2" iron pipe, 0.3' tall, in good condition and solid in the ground. We find a sandstone rock with an "X" on the top, 0.4' south. This rock was found per G34, Pg. 2. There is a steel fence post 0.9' North. Note: there is a new slide area with 2 large stumps directly above BCIP at approx. 250'.


Old BT Hathorn 1855 BLM Website
 Found a 44" Douglas Fir stump, S27°30'E, 13.25' to face, 14.43' to heart center. Stump has a chopped out face with scribes visible and a BLM tag in place. We paint the face in blue. FAIR CONDITION

Old BT Boulder 1978 G34, Pg. 3A
 Found a 38" Hemlock, S17°E, 33.58' to right side center. We find a healed blaze and a BLM tag in place. We paint the face and a band around the tree in blue. GOOD CONDITION

Old BT Boulder 1978 G34, Pg. 3A
 Found a 22" Hemlock, N25°E, 42.78' to right side center. We find a healed blaze and a BLM tag in place. We paint the face and a band around the tree in blue. GOOD CONDITION

New BT
 A 40" Hemlock, S60W, 13.80' to a nail at left side center. We bank scribe "1/4 S5 BT". We paint the scribes and a band around the tree in blue and attach a yellow Coos County tag.

Present:
 Matthew Martin
 Bill Hales

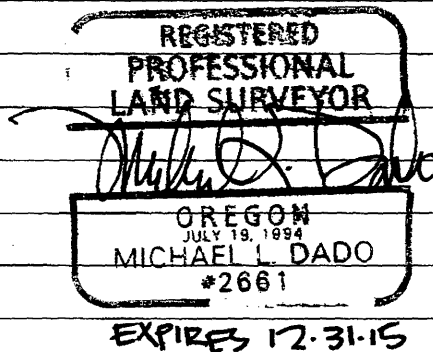

FILED

Date: 3-9-2015 By: X
 This survey consists of:
 Map: _____
 Narrative: _____
 Corner Pt: CS 65/87-34

DOUGLAS COUNTY
 SURVEYOR

C.S. File No 65/87-34

240700 T30-9