

FILED
Date: 3/13/2015 By: X
This survey consists of:

CORNER REPORT FORM

Section 22 Township 31 S Range 5 W
Douglas County Date March 11, 2015
PLSS Number 400400

Map: _____
Narrative: _____
Corner Rpt: CS 65/87-36
DOUGLAS COUNTY
SURVEYOR

CORNER DESIGNATION

Corner common to SEctions 15, 16
21 and 22.

___ Condition Report only
___ Not Found
X Renewed
___ Unrecorded
___ Surveyed In
___ Referenced out

Previous Renewals/Surveys, etc:

Original: W.H. Byars in 1882. Found on C.S. 51/56 by Victor S. King.
1982 B.L.M. resurvey set brass cap. Found by Shaner on M 112-49.

Monument(s) & Accessories Found: (Condition and Source)

Found the 1982 B.L.M. Brass Cap.

All bearing trees are gone except for a 15" diam. Madrone which
bears S. 84° W., 35.6 feet having a healed face and being broken off
at the top.

Monument Detail

Sketch

Standard B.L.M. Brass Capped iron pipe.

Monument Set (Procedures and Description)

N/A

New Accessories

A 13" diam. Fir scribed "T31S R5W S22 BT" bears S. 38° E., 43.4 feet.

A 15" diam. Fir scribed "T31S R5W S16 BT" bears N. 67° W., 28.4 feet.

Six foot steel posts are set 2 feet East and 4 feet South.

Surveyor's Seal

Location & Comments

Compass Declination 15° E

Firm/Agency: David Edwards Land Surveying


Address: P.O. Box 361

Oakland, Oregon 97462

Party Chief: Brant Miller

Notes: _____

Witness: Eric Sprinkle

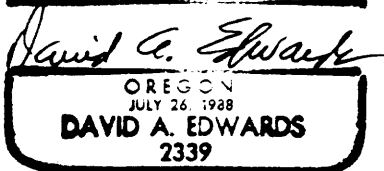

Renews 12/31/15

C.S. File 65/87-36