

CORNER REPORT FORM

FILED

Section 2  
Douglas County  
PLSS Number

Township 30S Range 9W  
Date 4-2015

Date: 4/14/2015 By: JC  
This survey consists of:  
Map:  
Narrative:  
Corner Rpt: CS65/87-47

DOUGLAS COUNTY  
SURVEYOR

CORNER DESIGNATION

C 1/4 S2

- Condition report only
- Not Found
- Renewed
- Unrecorded
- Surveyed In
- Referenced out


Previous Renewals/Surveys, etc:

SET BY SHANER M 44-51

Monument(s) & Accessories Found: (Condition and Source)

BRASS CAP  
18" D FIR N 40 E 19.8 FEET GOOD SCAR  
14" D FIR S 79 E 34.6 FEET GOOD SCAR

Monument Detail

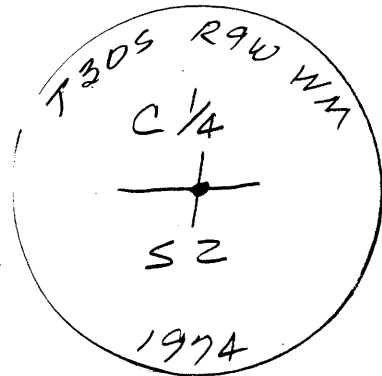

Sketch

Monument Set (Procedures and Description)

New Accessories

New BT'S  
14" MADRONE N 82W 22.7 FT  
29" D. FIR S 79W 44.3 FT  
Both Scribed C 1/4 S 2 BT

Surveyor's Seal

Location & Comments

HAND Held GPS  
LAT E 40129

Compass Declination  
Firm/Agency: I.e. Engineering, Inc.  
Address: 809 SE Pine St., Roseburg, OR 97400

Party Chief: N From Dahl  
Notes:  
Witness: R. OLSEN

REGISTERED  
PROFESSIONAL  
LAND SURVEYOR

OREGON  
JULY 14, 1973  
RONALD A. QUIMBY  
1654

N 42° 59.358  
W 123° 49.911

C.S. File 65/87-47