

CORNER REPORT FORM

FILED

Section 2 Township 30S Range 9W
Douglas County Date 4-2015
PLSS Number 540700

Date: 4-14-2015 By: JC
This survey consists of:
Map: _____
Narrative: _____
Corner Rpt: CS 65/87-48
DOUGLAS COUNTY
SURVEYOR

CORNER DESIGNATION

1/4 COR 535
S 2

- Condition report only
- Not Found
- Renewed
- Unrecorded
- Surveyed In
- Referenced out

Previous Renewals/Surveys, etc:


DCSO 1959 CS49-100 SHAWER M 49-51
BLM Resurvey 1966
BLM Resurvey 1996

Monument(s) & Accessories Found: (Condition and Source)

DCSO BRASS CAP
25" W. FIR N31°E 16.8 FT GOOD SCAR
43" D. FIR N67°E 10.6 FT VISIBLE "S" ON BARK SCRIBE
21" X 7" TALL FIR STUMP S13W 37.6 Feet GOOD SCAR

Monument Detail

Sketch

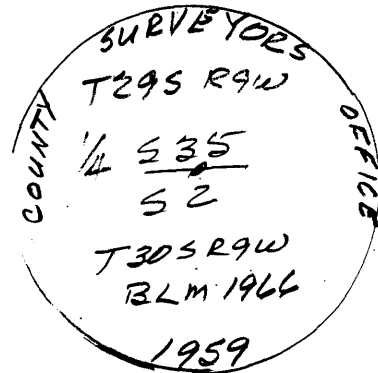

Monument Set (Procedures and Description)

New Accessories

New BT.
16" FIR S25°E 16.6 Feet scribed 1/4 S2 BT

Surveyor's Seal



Location & Comments

HAND HELD
LATE LONG
NAD 1983

N 42°59' 774
W 123°43' 927

Compass Declination
Firm/Agency: i.e. Engineering, Inc.
Address: 809 SE Pine St., Roseburg, OR 97470

Party Chief: N. From Dahl
Notes:
Witness: ROSEN

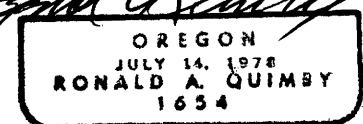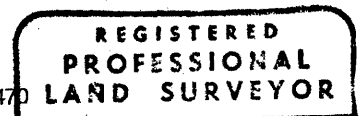

C.S. File EXP 12-31-16
CS 65/87-48

CORNER IS APPROX.
150' SOUTH OF ROAD
AT CORNER OF PARTIAL
CUT UNIT.