

BT6
COUNTY SURVEYOR'S RECORD
 OF
RE-ESTABLISHED GOVERNMENT CORNERS

Decl. Compass 17° E Mo. February 5 Day 2015 Year No. Book Page

Old Monument (GONE) Rogers 1991 BLM# 344, 345

Found 3 BTs, a 5/8" iron rod and a 1.5' diameter hole in the ground. We find the magnet set by Rogers in said hole.

New Monument

We return Rogers' magnet into said hole and based on the existing accessories, we set a 2" x 36" galvanized iron pipe with a 2 1/2" brass cap marked as shown above, cemented into the top of the pipe, solid and flush in the ground, from which we measure the following accessories:

Old BT Porter 1907 G34, Pg. 006

Found a 24" Douglas Fir stump, N71°30'E, 20.17' to face of stump, 9" out from center.

We find visible scribes, though the front 1/2 of the stump is gone. We paint the face in blue. POOR CONDITION

Old BO origin unknown found by Rogers 1991

Found a bent 5/8" iron rod, S61°30'W, 20.17' to a point where rod enters ground.

Though bent to the south, the rod is in good condition and solid in the ground.

Old BT Rogers 1991 BLM# 344

Found a 13" Douglas Fir tall stump, 6' tall, N77°W, 9.89' to right side center. We

find a healed blaze. We add a new tag and paint the face and a band around the stump in blue. GOOD CONDITION

Old BT Rogers 1991 BLM# 345

Found a 14" Douglas Fir, S45°W, 15.08' to left side center. We find a healed blaze

and a BLM tag in place. We paint the face and a band around the tree in blue.

GOOD CONDITION

Old BT Rogers 1991 BLM# 344

Found a 13" Douglas Fir, S5°E, 17.88' to left side center. We find a healed

blaze and a BLM tag in place. We paint the face and a band around

the tree in blue. GOOD CONDITION

Old BT Hoffine 1995 CS. 33-B-27

Found a 24" Douglas Fir stump, N71°E, 32.17' to heart center. We chop

out face and find visible scribes, but no tag. We paint the top of the

stump in blue. POOR CONDITION

New BO

A 15" Douglas Fir stump, 1' tall, N22°30'E, 36.97' to a spike and Coos County

washer driven in at heart center. We chop an "X" in the face. We paint

the "X" in blue and attach a yellow Coos County tag.

Present:

Matthew Martin

Bill Hales


FILED

Date: 4/28/2015 By: JC
 This survey consists of:

Map: _____

Narrative: _____
 Corner Rpt: CS 65/87-49

DOUGLAS COUNTY
 SURVEYOR

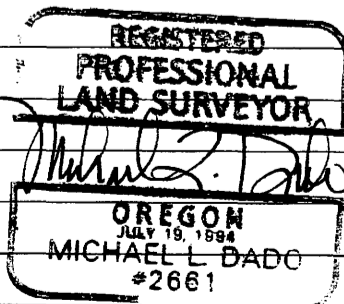

EXPIRES 12-31-15

C.S. FILE 65/87-49

400160 T29-9

400700 T30-9