

BT6
COUNTY SURVEYOR'S RECORD
OF
RE-ESTABLISHED GOVERNMENT CORNERS

Decl. Compass 17° E Mo. February 25 Day 2015 Year No. Book Page

Old Monument Glen 1959 G27, Pg. 62

Found 3/4" brass cap on a 2 1/2" iron pipe, 0.4' tall, in good condition and solid in the ground. Note: Monument leans to the NW. DCSO Vol. 30, Pg. 12849

Old BT Chapman 1875 G27, Pg. 005

Found a 34" Douglas Fir tall stump, 7.5' tall, N40°E, 23.10' to left side center. We find a healed scar on the face with nails and bits of an old tag in place. We chop a new "X" in the face and paint the "X" and "BT" in blue and attach a new yellow Coos County tag. Note: there are logging footholes cut into the face and right side of this stump. This stump may possibly be an original Hathorn 1855 bearing tree. GOOD CONDITION

Old BT LaFlamme 1986 no record

Found a 30" White Cedar tall stump, 6' tall, N85°W, 16.0' to left side center. We find visible scribes in an open blaze (S34 BT 378). We chop a new high "X" and paint the open face, the "X", and "BT" on the stump in blue.

Stump was found by Skeasick 2001 per DCSO Vol 53, Pg. 20724-5. GOOD

Old BT Skeasick 2001 DCSO Vol 53, Pg. 20724-5


Found an 18" Hemlock, S75°W, 104.71' (S73°30'W-107.0' rec.) to right side center. We find a mostly healed blaze. We paint the face and a band around the tree in blue and add a new yellow Coos County tag. GOOD CONDITION

Old BT Skeasick 2001 DCSO Vol 53, Pg. 20724-5

Found an 8" Hemlock stump, N25°W, 42.66' to heart center. We find visible scribes. We paint the top of the stump in blue. GOOD CONDITION

New BT
A 6" Hemlock, N30°W, 39.13' to a nail at right side center. We bank scribe "T28 R9 S34 BT" low and chop an "X" high. We paint the scribes and "X" in blue and attach a yellow Coos County tag.

Present:
Matthew Martin
Bill Hales
Michael L. Dado

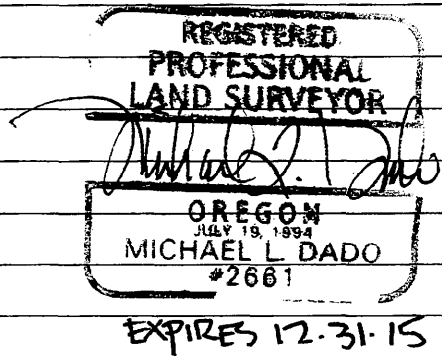

FILED
Date: 4/28/2015 By: JC
This survey consists of:
Map:
Narrative:
Corner Rpt: CS 65/87-52

DOUGLAS COUNTY SURVEYOR 500700 T 29-9