


436

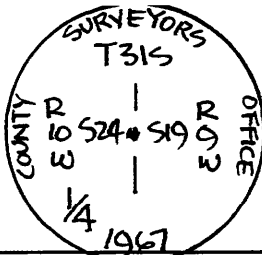

**BT6**  
**COUNTY SURVEYOR'S RECORD**  
 OF  
**RE-ESTABLISHED GOVERNMENT CORNERS**

Decl. Compass 17°E Mo. March 17 Day 2015 Year No. Book Page

Old Monument Powell 1967 Book 54, Pg. 32

Found 2 1/2" brass cap on an 1 1/2" o.d. iron pipe, 0.25' tall, in good condition and solid in the ground. We set a Douglas Fir post 3' North and paint the top in blue.

Old BT Byars 1901 CT47, Pg. 10

Found a 2" Douglas Fir, N66°E, 8.50' to right side center. We find a large healed scar facing the corner with a Coos Bay Lumber tag in place. We paint the face and a band around the tree in blue. GOOD

Old BT Simon 1993 Vol. 5-19556

Found a 10" Douglas Fir, N84°W, 35.65' to left side center. We find a healed blaze, but no tag. We paint the face and a band around the tree in blue and attach a new yellow tag GOOD CONDITION

New BO


An 18" White Cedar stump, S58°E, 13.65' to a spike and Coos County washer driven in at heart center. We chop an "X" in the face and paint the "X" and the top of the stump in blue and attach a yellow Coos County tag.

New BT

A 4" Douglas Fir N34°30'W, 10.39' to a nail at right side center. We blaze and scribe "BT" low and "X" high. We paint the blaze, scribes "X" and a band around the tree in blue and attach a yellow Coos County tag

Present:

Matthew Martini  
Bill Hales  
Michael L. Dado

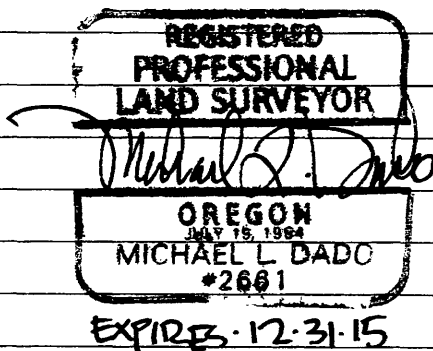

FILED

Date: 4-28-2015 By: x

This survey consists of:

Map: \_\_\_\_\_

Narrative: \_\_\_\_\_

Corner Rpt: CS 65/87-60

DOUGLAS COUNTY  
 SURVEYOR

100340 731-9