

BT6  
COUNTY SURVEYOR'S RECORD  
OF  
RE-ESTABLISHED GOVERNMENT CORNERS

Decl. Compass 17°E Mo. April 1 Day 2015 Year No. Book Page

Old Monument Powell 1965 Book 12, Pg. 03  
Found 2 1/2" brass cap on a 1" o.d. iron pipe, 1.1' tall, in good condition and fairly solid in the ground, leaning slightly to the South. Cap is oriented N42°E. We set a Cedar post 3' North and paint the top in blue.

Lat. & Long. per Garmin hand held = 42°56'46.8" + 123°49'16.6"

Old BT Bushy 1893 G41, Pg. 41

Found a 24" White Cedar stump, N62°30'E, 31.02' to heart center. We find a possible chopped out face. We paint the face in blue. FAIR COND.

Old BT Bushy 1893 G41, Pg. 41

Found a 31" Douglas Fir, N32°W, 21.60' to left side center. We find a healed blaze and axe marks up high. We paint the face, the axe marks and a band around the tree in blue and add a new yellow tag. GOOD COND.

Old BT Powell 1965 Book 12, Pg. 03

Found a 42" Douglas Fir high stump, 7' tall, S16°30'E, 25.11' to right side center. We find a healed blaze and a 1965 BLM tag. We paint the face and a band around the stump in blue. GOOD CONDITION


New BT

A 15" Douglas Fir with a dead top, N45°30'E, 29.93' to a nail at right side center. We blaze and scribe "1/4 S19 BT." We paint the blaze, scribes and a band around the tree in blue and attach a yellow Coos County tag.

New BT

A 12" Hemlock, S55°W, 21.18' to a nail at right side center. We bark scribe "1/4 S24 BT." We paint the scribes and a band around the tree in blue and attach a yellow Coos County tag.

Present:  
Matthew Martin  
Bill Hales

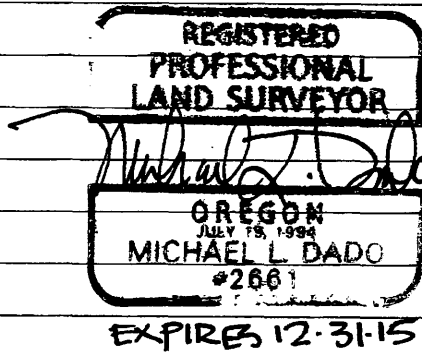

FILED

Date: 4/28/2015 By: SC  
This survey consists of:  
Map:  
Narrative:  
Corner Rpt: CS 65 / 87-63

DOUGLAS COUNTY  
SURVEYOR

100340 T30-9

C.S. FILE 65 / 87-63