

Filed 5/11/2015

T 24S R 2W

W.C

5-2015

S28	S27
S33	S34


FOUND OK AS
PER EDWARDS

IN 156-7

DCSO RENEWAL

1974 PLSS # 400200

REGISTERED
PROFESSIONAL
LAND SURVEYOR

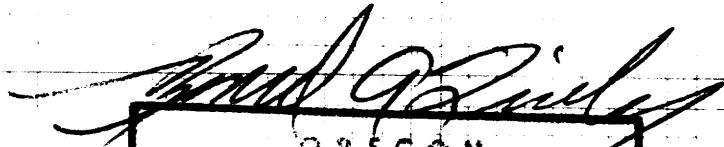

OREGON
JULY 14, 1978
RONALD A. QUIMBY
1634

EXP 12-31-10

CS65189-1