

FILED
Date: 5/11/2015 By: JC
This survey consists of:

CORNER REPORT FORM

Section 34 Township 24S Range 2W
Douglas County Date 5-2015
PLSS Number 500100

Map: _____

Narrative: _____
Corner Rpt: CS 65/89-2

DOUGLAS COUNTY
SURVEYOR

CORNER DESIGNATION

SEC COR S34/S35
S3/S2

- Condition Report only
- Not Found
- Renewed
- Unrecorded
- Surveyed In
- Referenced out


Previous Renewals/Surveys, etc:
Est. By BLM 1951-1963

Monument(s) & Accessories Found: (Condition and Source)

FD GLO BEASS CAP
29" CEDAR N45 1/2 E 60.7 FT GOOD SCAR
40" CEDAR S38 E 21.1 FT GOOD SCAR
40" CEDAR S46 W (Rec 46 1/4) 23.8 FT GOOD SCAR
31" CEDAR N57 W 50.8 FT GOOD SCAR

Monument Detail

Sketch

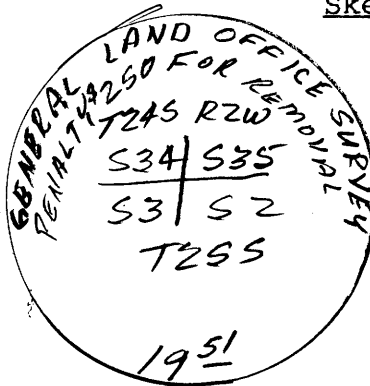

Monument Set (Procedures and Description)

New Accessories

N.E. CORNER TRACT 38 BEARS N16° E 299 FT

Surveyor's Seal

Location & Comments


HAND Held
LAT 43° 26.209
LONG. 122° 55.936

Compass Declination 15 1/2
Firm/Agency: i.e. Engineering, Inc.
Address: 809 SE Pine St., Roseburg, OR 97470

Party Chief: N. FROMDAHL

Notes:

Witness: R. OLSEN

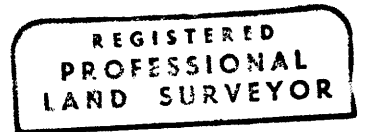

Ronald A. Quimby
OREGON
JULY 14, 1978
RONALD A. QUIMBY
1654

EXP 12-31-16
C.S. File 65/89-2