

FILED

Date: 5/11/2015 By: JC

This survey consists of:

Map: _____

Narrative: _____

Corner Rpt: CS 65/89-5

DOUGLAS COUNTY
SURVEYOR

CORNER REPORT FORM

Section 34 Township 24S Range 2W
Douglas County Date 5-2015
PLSS Number 400113

CORNER DESIGNATION

S.W. 534
NW TR 38



Condition Report only
Not Found
Renewed
Unrecorded
Surveyed In
Referenced out

Previous Renewals/Surveys, etc:


SET BY BLM Resurvey 1951-1963

Monument(s) & Accessories Found: (Condition and Source)

BLM BRASS CAP
43" D. FIR N70E 50.0 FT (REC 50.8 FT) GOOD SCAR
40" CONCR SW 27.7 FT (REC 24.4 FT) GOOD SCAR

Monument Detail

Sketch

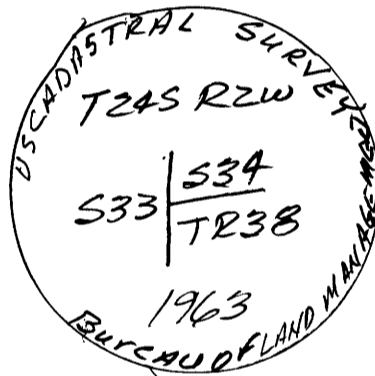

Monument Set (Procedures and Description)

New Accessories


A 9" FIR N36E 36.3 FT Scribed T24S R2W S34 BT
A 20" FIR N21W 15.5 FT Scribed T24S R2W S33 BT

Surveyor's Seal

Location & Comments

HAND HELD
LAT 43°26.208
LONG 122°55.936


Compass Declination 15 1/2
Firm/Agency: i.e. Engineering, Inc.
Address: 809 SE Pine St., Roseburg, OR 97470

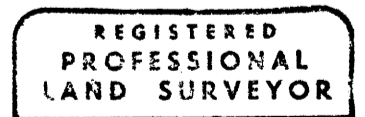

Party Chief: N. FROMMHAL

Notes:

Witness: R. OLSEN

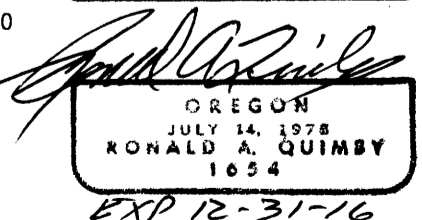

C.S. File 65/89-5