

OREGON CORNER RESTORATION FORM

TOWNSHIP 30 RANGE 9

FILED
Date: 5/13/2015 By: JC
This survey consists of:
Map: _____
Narrative: _____
Corner Rpt: CS 65/89-6
DOUGLAS COUNTY
SURVEYOR

Corner Designation

T30S R9W

S6 only
N 1/4 Corner

- Condition Report Only
- Not Found
- Renewed
- Unrecorded
- Surveyed in
- Referenced Out

Previous Renewals / Surveys, etc.

Bowder, Farnsworth & Rogers, 1982 (G34, Pg. 15A; 16A); Porter, 1907 (G34, Pg. 003); Hathorn, 1855 (BLM Website).

Monument(s) & Accessories Found: (Condition and Source)

We find a 3 1/4" aluminum cap on a 2 1/2" aluminum pipe, 0.2' tall, in good condition and solid in the ground, per Bowder, Farnsworth & Rogers, 1982 (G34, Pg. 15A); Douglas Fir pitch post with yellow BT tag 3' South of monument; 42" Douglas Fir stump, N46°E-43.40'; 16" Hemlock stump, S62°W-35.34'; 48" White Cedar stump, S30°W-54.89'.

Monument Detail

Sketch


Monument Set

NONE

New Accessories

NONE

Locations & Comments

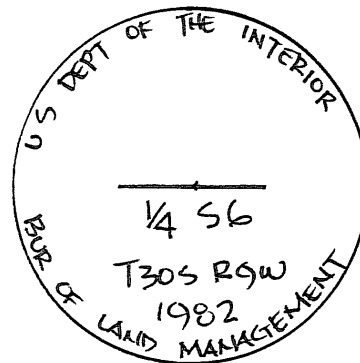

Compass Declination 17°E
Firm/Agency Coos County Surveyor
Address Coos County Courthouse
250 N. Baxter
Coquille, OR 97423

Party Chief: Matthew Martin
Notes: Matthew Martin
Crew: Bill Hales

Date: February 11, 2015

