

FILED

Date: 7-2-2015 By: X

This survey consists of:

Map: _____

Narrative: _____

Corner Rpt: CS 65/89-7

CORNER REPORT FORM

Section 2 Township 33S Range R5W
Douglas County Date 6/15
PLSS Number 500640

DOUGLAS COUNTY
SURVEYOR

CORNER DESIGNATION

1/4 53/52

- Condition Report only
- Not Found
- Renewed
- Unrecorded
- Surveyed In
- Referenced out

Previous Renewals/Surveys, etc.:

IRVING 1930 RM 1-11 K. DeGroot 1999 M 133-78
BLM RESURVEY 1973-1974

Monument(s) & Accessories Found: (Condition and Source)

BLM BRASS CAP
41" FIR N30³14 E 98³ FT GOOD SCAR
56" S. PINE S36¹2 W 75⁹ FT GOOD SCAR
29" FIR N60 E 40⁶ FT GOOD SCAR

Monument Detail



Sketch

Monument Set (Procedures and Description)

New Accessories

11" chincipin N29⁰W 29.4 FT scribed 1/4 53 RT

Surveyor's Seal

Location & Comments


HAND HELD
Lat & Long
N 42° 43' 9.17
W 123 16.168

Compass Declination 15 1/2
Firm/Agency: i.e. Engineering, Inc.
Address: 809 SE Pine St., Roseburg, OR 97470


Party Chief: N. FROMMANN

Notes:

Witness: R. OLSON

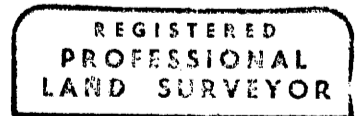

Ronald A. Gimby

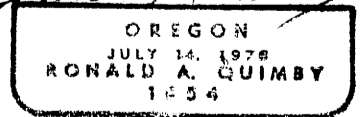

EXP 12-31-16

C.S. File _____

CS 65/89-7