

FILED

Date: 7/2/2015 By: *K*

This survey consists of:

Map: \_\_\_\_\_

Narrative: \_\_\_\_\_

Corner Rpt: CS65/89-8

DOUGLAS COUNTY  
SURVEYOR

CORNER REPORT FORM

Section 2 Township 335 Range 5W  
Douglas County Date 6/15  
PLSS Number 500600

CORNER DESIGNATION

53/52  
510/511

- Condition Report only
- Not Found
- Renewed
- Unrecorded
- Surveyed In
- Referenced out

Previous Renewals/Surveys, etc:


GLD Resurvey 1957 BLM Dependent Resurvey 1986-1992  
DCSO 1967

Monument(s) & Accessories Found: (Condition and Source)

GLD BRASS CAP  
20" FIR N73 1/4° E 38.9 FT GOOD SCAR  
23" FIR S59° E 42.2 FT GOOD SCAR  
14" Rotted Cedar Stump S22 E 37.6 FT  
20" FIR S42W 33.3 FT GOOD SCAR

Monument Detail

Sketch

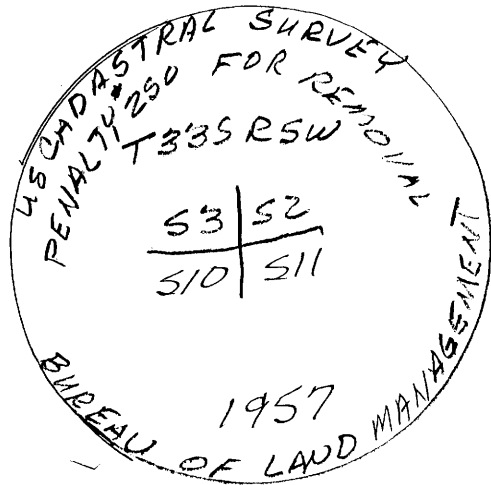

Monument Set (Procedures and Description)

New Accessories


A 7" FIR N67° W 9.9 FT Scribed T335 R5W 53 RT

Surveyor's Seal

Location & Comments

HAND Held  
LAT & LONG  
42° 43' .479  
123° 16' .161

Compass Declination 15 1/2  
Firm/Agency: i.e. Engineering, Inc.  
Address: 809 SE Pine St., Roseburg, OR 97470  
Party Chief: N. Fromdahl  
Notes:  
Witness: R. OLSON

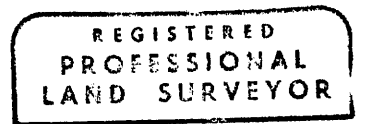

*Ronald A. Quimby*  
OREGON  
JULY 14, 1978  
RONALD A. QUIMBY  
1954

ETP12-31-16

C.S. File 65/89-8