

FILED
Date: 7/28/2015 By: sc

This survey consists of:

Map: _____

Narrative: _____

Corner Rpt: CS 65/89-12

DOUGLAS COUNTY
SURVEYOR

CORNER REPORT FORM

Section 16 Township 32S Range 7W
Douglas County Date 7/15
PLSS Number 340400

CORNER DESIGNATION

$\frac{1}{4}$ $\frac{S16}{S21}$

- Condition Report only
- Not Found
- Renewed
- Unrecorded
- Surveyed In
- Referenced out

Previous Renewals/Surveys, etc:

PRICE 1956 CS File 42/143 BLM Remonumentation 1978
DCSO 1967 CS File 54/36


Monument(s) & Accessories Found: (Condition and Source)

BLM BRASS CAP

12" FIR S48°E 40³ FT GOOD SCAR
18" FIR N77W 121⁴ FT " "
20" FIR N48W 25¹ FT " "

Monument Detail

Sketch

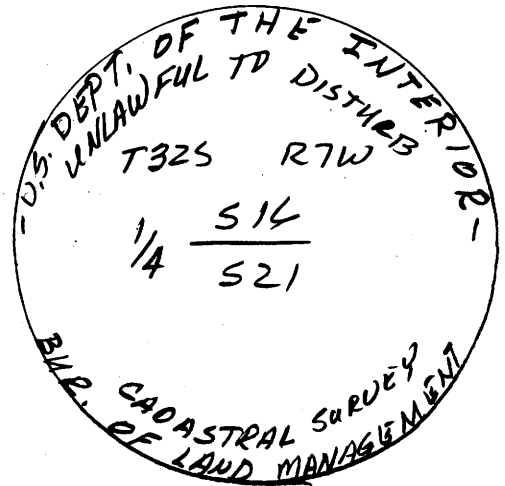

Monument Set (Procedures and Description)

New Accessories

4" FIR N22E 3¹/₂ FT scribed $\frac{1}{4}$ S16 BT

Surveyor's Seal

Location & Comments

HAND HOLD
LAT & LONG
N 42°46'949
W 123°32.081
COR. IN CUT BANK
WEST SIDE OF
ROAD

Compass Declination 15¹/₂
Firm/Agency: i.e. Engineering, Inc.
Address: 809 SE Pine St., Roseburg, OR 97470
Party Chief: M From dah
Notes:
Witness: R. OLSEN

REGISTERED
PROFESSIONAL
LAND SURVEYOR

OREGON
JULY 14, 1978
RONALD A. QUIMBY
1654

EXP 12-31-16
C.S. File 65/89-12