

FILED
Date: 7/28/2015 By:
This survey consists of:
Map: _____
Narrative: _____
Corner Rpt: CS 65/89-13

DOUGLAS COUNTY
SURVEYOR

CORNER REPORT FORM

Section 14 Township 32S Range 7W
Douglas County Date 7/15
PLSS Number 400440

CORNER DESIGNATION

1/4 516/515

Condition Report only
 Not Found
 Renewed
 Unrecorded
 Surveyed In
 Referenced out

Previous Renewals/Surveys, etc:


BLM RESURVEY 1978 DCSO Rec. Vol. 42 Pgs 16510-11

Monument(s) & Accessories Found: (Condition and Source)

BLM BRASS CAP
15" FIR N71°E 41.6 FT GOOD SCAR
59" SUGAR PINE SNAG. SSE 22.4 FT
31" FIR N64°W 40.3 FT GOOD SCAR
20" MADRONE N48W 46.2 FT " "

Monument Detail

Sketch

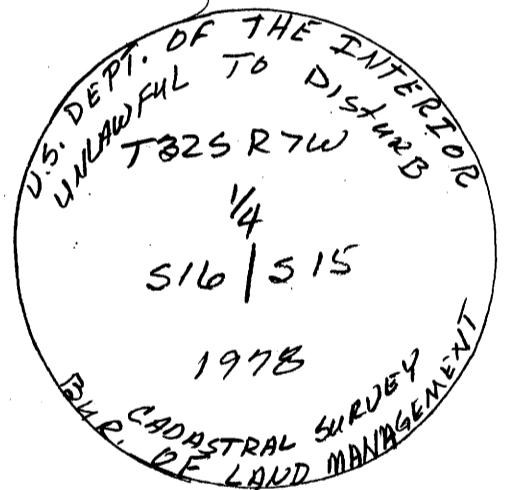

Monument Set (Procedures and Description)

New Accessories

6" MADRONE S63W 24.7 FT scribed 1/4 516 BT

Location & Comments

HAND HELD
LAT & LONG.
N 42°47'37"
W 123°31.503

Compass Declination 15 1/2°
Firm/Agency: i.e. Engineering, Inc.
Address: 809 SE Pine St., Roseburg, OR 97470

Party Chief: N FROMDAHL

Notes:

Witness: R. OLSEN

Surveyor's Seal

REGISTERED
PROFESSIONAL
LAND SURVEYOR

Ronald A. Quimby
OREGON
JULY 14, 1978
RONALD A. QUIMBY
1054

EXP 12-31-16

C.S. File 65/89-13