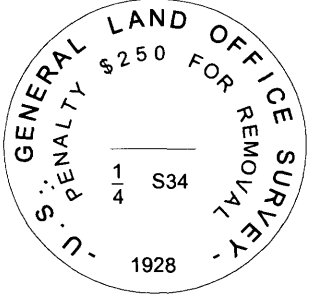


USDA-FOREST SERVICE

Index

CORNER RECORD (SEARCH)

File No. V15 PROJ. NO. _____ CORNER 1/4
 TOWNS. 25 1/2 S RANGE 1 E R.D. North Umpqua COUNTY Douglas GCDB# 440200
 MERID. Wil. FOREST Umpqua STATE Oregon

| <p>CORNER DIAGRAM</p>  | <p>DESCRIBE CORNER MONUMENT FOUND Found a 1 inch diameter galvanized iron pipe bent to the ground with a 2 1/2 inch diameter brass cap marked as shown.</p> <p>DESCRIBE BEARING TREES OR OTHER OFFICIAL ACCESSORIES FOUND</p> <table border="1" style="width:100%; border-collapse: collapse;"> <thead> <tr> <th>DIA</th> <th>TYPE</th> <th>BEARS</th> <th>DIST</th> <th>FACE/MARKINGS</th> </tr> </thead> <tbody> <tr> <td>15"</td> <td>Fir snag</td> <td>S 15° W</td> <td>19.8 ft.</td> <td>Axe work and fragmentary scribe marks</td> </tr> <tr> <td>indt</td> <td>fir stump</td> <td>S 25° E</td> <td>32.3 ft.</td> <td>none</td> </tr> </tbody> </table> | DIA | TYPE | BEARS | DIST | FACE/MARKINGS | 15" | Fir snag | S 15° W | 19.8 ft. | Axe work and fragmentary scribe marks | indt | fir stump | S 25° E | 32.3 ft. | none |
|---|--|---------|----------|---------------------------------------|------|---------------|-----|----------|---------|----------|---------------------------------------|------|-----------|---------|----------|------|
| DIA | TYPE | BEARS | DIST | FACE/MARKINGS | | | | | | | | | | | | |
| 15" | Fir snag | S 15° W | 19.8 ft. | Axe work and fragmentary scribe marks | | | | | | | | | | | | |
| indt | fir stump | S 25° E | 32.3 ft. | none | | | | | | | | | | | | |
| <p>PHOTO IDENTIFICATION DATA</p> <p>Photo No. _____ Filed At. _____ Obj. Ident. _____ Ident. By _____ Signature _____</p> | <p style="text-align: center;">FILED</p> <p>Date: <u>8/19/2015</u> By: <u>SC</u> This survey consists of: Map: _____ Narrative: _____ Corner Rpt: <u>CS 65/89-22</u></p> <p style="text-align: center;">DOUGLAS COUNTY SURVEYOR</p> | | | | | | | | | | | | | | | |
| <p>PLANE COORDINATE POSITION DATA</p> <p>State _____ Zone _____ North _____ West _____ Estab. By _____ Signature _____</p> | <p>DESCRIBE CORNER LOCATION RELATIVE TO NEAR-BY FEATURES, ALSO HOW TO REACH CORNER The corner is on a ridge 105 feet East of Forest Road 4713 and 1/4 mile North of the junction with Forest Road 4713-300</p> | | | | | | | | | | | | | | | |

Signature _____ Title _____ Division _____ Headquarters _____ Date 7100-52 (3/68)

CORNER RECORD (PERPETUATION)

| | |
|--|---|
| <p>MONUMENT : DESCRIBE NEW MONUMENT SET, OR WORK DONE TO PRESERVE EXISTING MONUMENT I removed and straightened the iron pipe and replaced it in the exact position flush in a 24 inch diameter collar of stone.</p> <p>ACCESSORIES : DESCRIBE NEW BT's WITNESS OBJECTS ETC. ESTABLISHED, OR WORK DONE TO PRESERVE EXISTING EVIDENCE A new 14" Cedar brs. S 65° E, 34.7 ft., marked "1/4 S34" "BT" on a double blaze. A new 17" D. Fir brs. S 4° E, 31.4 ft., marked "1/4S34" "BT" on a double blaze. A new 13" Hemlock brs. N 20 1/2 W, 17.7ft., Marked "X" "BT" on a double blaze. A new 10" D. Fir brs. N 79° W, 4.6 ft., marked "X" BT" on a double blaze.</p> <p>Placed an aluminum guard post with monument sign 2 feet North of the monument.</p> | <p style="text-align: right;"><i>exp 12/31/2016</i></p> <div style="border: 1px solid black; padding: 5px; text-align: center;"> REGISTERED PROFESSIONAL LAND SURVEYOR </div> <p style="text-align: center; font-family: cursive; font-size: 1.2em;"><i>John Ransom</i></p> <div style="border: 1px solid black; padding: 5px; text-align: center;"> OREGON JULY 21, 1992 JOHN C. RANSOM 2561 </div> |
| <p>DONE BY: <u>Hillman</u> TITLE <u>Tech</u> DATE <u>1/2015</u> Certified Cor. Record Prepared? _____ Filed At: _____</p> <p style="text-align: center;">REMARKS</p> <p>Measurements made with staff compass (15 3/4° declination) and a steel tape.</p> | |

Index File No V15 T. 25 1/2 S R. 1 E M. Wil. Proj No. _____ Cor. 1/4

C.S. File No 65/89-22