

FILED

Date: 9-30-2015 By: JC

This survey consists of:

Map: _____

Narrative: _____

Corner Rpt: CS 65/89-25

DOUGLAS COUNTY
SURVEYOR

CORNER REPORT FORM

Section 12 Township 31S Range 3W

Douglas County

Date 9/2015

PLSS Number 700540

CORNER DESIGNATION

1/4 512 only

- Condition Report only
- Not Found
- Renewed
- Unrecorded
- Surveyed In
- Referenced out

Previous Renewals/Surveys, etc:

MEUSCH 1906 WIBBITT 1978 M 72-76

MARKHAM 1959 CS 42/392 DCSO GIS CS 47/33-1

Monument(s) & Accessories Found: (Condition and Source)

3" BRASS CAP


11" Hemlock N74°E 16.4 FT GOOD SCAR

42" CEDAR S48E 54.2 FT " "

27" FIR S54W 25.8 FT " "

Monument Detail

Sketch

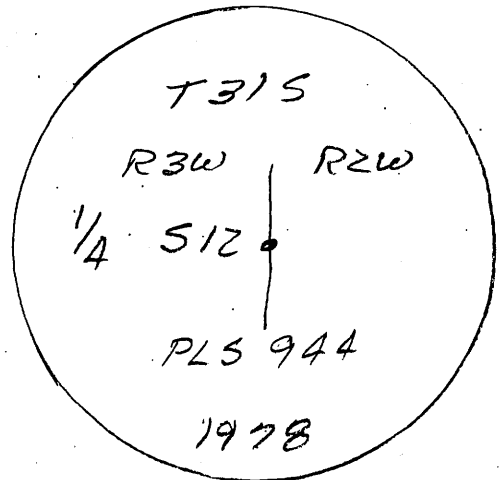

Monument Set (Procedures and Description)

New Accessories

9" FIR N76W 25.1 FT scribed 1/4 512 BT

Surveyor's Seal

Location & Comments

AREA BADLY
burnt 8/2015

HAND HELD LATE
LONG

N 42° 53.617'

W 122° 57.613'

Compass Declination 15 1/2° E

Firm/Agency: i.e. Engineering, Inc.

Address: 809 SE Pine St., Roseburg, OR 97470

Party Chief: N. Fromdahl

Notes:

Witness: R. OLSON

REGISTERED
PROFESSIONAL
LAND SURVEYOR

Ronald A. Quimby
OREGON
JULY 14, 1978
RONALD A. QUIMBY
1054

EXP 12-31-16

C.S. File 65/89-25