

FILED

Date: 9-30-2015 By: JC

This survey consists of:

Map: _____

Narrative: _____
Corner Rpt: CS 65/89-30

DOUGLAS COUNTY
SURVEYOR

CORNER REPORT FORM

Section 12 Township 31 Range 3W
Douglas County Date 8/2015
PLSS Number 600600

CORNER DESIGNATION

Sec COR 2/1
11/12

Condition Report only
Not Found
Renewed
Unrecorded
Surveyed In
Referenced out

Previous Renewals/Surveys, etc:

Monument(s) & Accessories Found: (Condition and Source)

SEE M 166-29
FOR INFORMATION
ALL TREES ARE badly burnt
Added 600 spike to side/center
AT BASE OF ALL TREE'S

Monument Detail

Sketch

Monument Set (Procedures and Description)



New Accessories

Location & Comments

AREA badly
burnt 8/2015
HAND Held Lat
LONG
N 42° 54.060
W 123° 00.301

Compass Declination 15 1/2° E
Firm/Agency: I.e. Engineering, Inc.
Address: 809 SE Pine St., Roseburg, OR 97470
Party Chief: M. FROMM
Notes:
Witness: R. OIBON

Surveyor's Seal

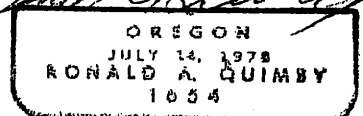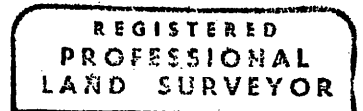

EXP 12-31-16

C.S. File 65/89-30