

FILED

Date: 9-30-2015 By: SC

This survey consists of:

Map: _____

Narrative: _____

Corner Rpt: CS 65/89-32

DOUGLAS COUNTY
SURVEYOR

CORNER REPORT FORM

Section 14 Township 31S Range 3W
Douglas County Date 8/2015
PLSS Number 600440

CORNER DESIGNATION

1/4 COR S14/S13

- Condition Report only
- Not Found
- Renewed
- Unrecorded
- Surveyed In
- Referenced out

Previous Renewals/Surveys, etc:

MARKHAM 1959 CS File 42/392
DCSD OFFICE 1965 CS 52/65


Monument(s) & Accessories Found: (Condition and Source)

DCSD BRASS CAP (BURNT)
16" FIR N56E 15.8 FT PARTIAL SCRIBE VIS. (BURNT)
44" CEDAR S13E 21.5 (BURNT)
19" FIR S74E 24.0 (BURNT)

DROVE 60D SPIKE IN SIDE CENTER OF ALL BT'S AT BASE
Set Alum Post 2' N.E.S OF CORNER

Monument Detail

Sketch

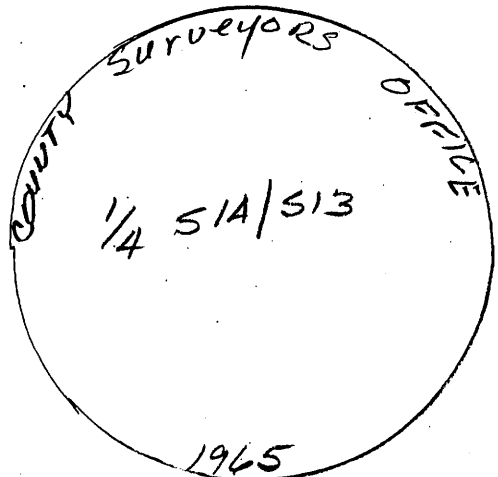

Monument Set (Procedures and Description)

New Accessories

6" FIR S73W 10.4' SCRIBED 1/4 S14 BT (BURNT)
60D SPIKE SET IN SIDE-CENTER AT BASE

Surveyor's Seal

Location & Comments

AREA BADLY BURNT
8/2015
CORNER IS ON
TOP OF SPUR
RIDGE

Compass Declination 15 1/2° E
Firm/Agency: I.e. Engineering, Inc.
Address: 809 SE Pine St., Roseburg, OR 97470
Party Chief: N. Eronidahl
Notes:
Witness: R. OLSON

REGISTERED
PROFESSIONAL
LAND SURVEYOR

Ronald A. Quimby
OREGON
JULY 14, 1978
RONALD A. QUIMBY
1054

EXP 12-31-16

C.S. File 65/89-32