

FILED

Date: 9/30/2015 By: JC
This survey consists of:

Map: _____

Narrative: _____

Corner Rpt: LS 65/89-34

DOUGLAS COUNTY
SURVEYOR

CORNER REPORT FORM

Section 12 Township 3/5 Range 3W
Douglas County Date 8/2015
PLSS Number 700520

CORNER DESIGNATION

5 1/16 S 12

- Condition Report only
- Not Found
- Renewed
- Unrecorded
- Surveyed In
- Referenced out

Previous Renewals/Surveys, etc:


SET BY MOFFITT M 72-76 1978
RUPPERT M 79-20 1980

Monument(s) & Accessories Found: (Condition and Source)

3" BRASS CAP
16" Hemlock bears NB2W 27.1 FT (REC NB19W 27' (6000 SCAR)
24" FIR S55°W 49' FT (6000 SCAR)
1/2" I. PIPE S76°E 45 FT
Trees Burnt but standing.

Monument Detail

Sketch

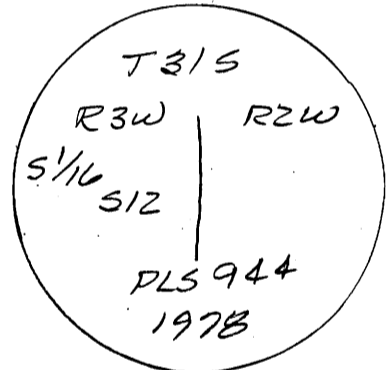

Monument Set (Procedures and Description)

New Accessories

Added spike to side center of trees
Alum post 2'± west.

Surveyor's Seal

Location & Comments

AREA Badly Burnt
8/2015
HAND Held LAT &
LONG

Compass Declination 16 1/2° E
Firm/Agency: i.e. Engineering, Inc.
Address: 809 SE Pine St., Roseburg, OR 97470

REGISTERED
PROFESSIONAL
LAND SURVEYOR

Party Chief: N. Frommlich
Notes:
Witness: R. OLSON

Ronald A. Quimby
OREGON
JULY 14, 1978
RONALD A. QUIMBY
1054

N 42°53'25"
W 122°59'54"

EXP 12-31-16

C.S. File 65/89-34