

FILED

Date: 9-30-2015 By: XC

This survey consists of:

Map: _____

Narrative: _____
Corner Rpt: CS 65/89-38

DOUGLAS COUNTY
SURVEYOR

CORNER REPORT FORM

Section 12 Township 31S Range 3W
Douglas County Date 8/2015
PLSS Number 640500

CORNER DESIGNATION

$\frac{1}{4}$ 12
13

- Condition Report only
- Not Found
- Renewed
- Unrecorded
- Surveyed In
- Referenced out

Previous Renewals/Surveys, etc:

MARKHAM 1959 CS 42/392
DCSO 1965 CS 52/63


RUPPERT 1980 M-79-20
Kleid 2015 M 166-40

Monument(s) & Accessories Found: (Condition and Source)

DCSO BRASS CAP
12" YEW S3E 35.4 DOWN & BURNT
18" FIR S61E 25.4 (BURNT) ADDED SPIKE TO SIDE CENTER
16" CEDAR NSBE 38.5 (BURNT) ADDE SPIKE TO SIDE-CENTER

Monument Detail

Sketch

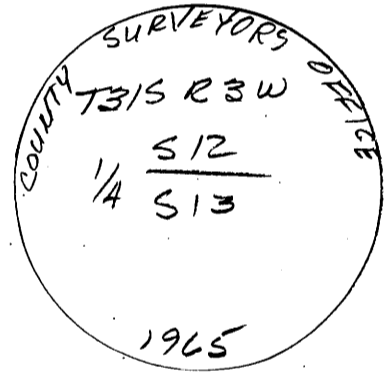

Monument Set (Procedures and Description)

New Accessories

15" Hemlock S8W 65 FT scribed 1/4 S12 RT
6" Hemlock N46W 17 FT scribed 1/4 S12 RT

Surveyor's Seal

Location & Comments

AREA BADLY BURNT
8/2015
Creek approx.
50 South
HAND HELD. Late
LONG.
N 42° 53' 11"
W 123° 00' 12"

Compass Declination 15 1/2° E
Firm/Agency: i.e. Engineering, Inc.
Address: 809 SE Pine St., Roseburg, OR 97470
Party Chief: N From Dahl
Notes:
Witness: R. OLSON

REGISTERED
PROFESSIONAL
LAND SURVEYOR

Ronald A. Quimby
OREGON
JULY 14, 1978
RONALD A. QUIMBY
1054

EXP 12-31-16

C.S. File 65/89-38