

FILED

Date: 9-30-2015 By: SC

This survey consists of:

Map: _____

Narrative: _____

Corner Rpt: C-2 65/89-39

DOUGLAS COUNTY
SURVEYOR

CORNER REPORT FORM

Section 15 Township 22 S Range 7 W
Douglas County Date 9/23/2015
PLSS Number 420440

CORNER DESIGNATION

Center-West 1/16 corner
of Section 15

- ___ Condition Report only
- ___ Not Found
- ___ Renewed
- ___ Unrecorded
- ___ Surveyed In
- ___ Referenced out

Previous Renewals/Surveys, etc:

Established by B.L.M. survey in 1965.
Plat approved in 1967.

Monument(s) & Accessories Found: (Condition and Source)

Standard B.L.M. brass capped iron pipe in good condition.

The fir N. $70\frac{1}{2}^{\circ}$ E. was pulled over by a logging operation and only a stump and root wad remain.

A 14" diameter D. Fir with healed blaze and tag bears S. $78\frac{1}{2}^{\circ}$ W., 20.5 feet.
(B.L.M. record=20.8 feet).

Monument Detail

Sketch

Standard B.L.M. brass capped iron
pipe of that era.

Monument Set (Procedures and Description)

N/A

New Accessories

A 15" diameter Fir scribed "CW 1/16 S15 BT" bears N. 18° E., 27.73 feet
to a 16d nail driven side-center.

Surveyor's Seal

Location & Comments

Compass Declination 15^o East


Firm/Agency: David Edwards Land Surveying

Address: P.O. Box 361
Oakland, OR. 97462

Party Chief: David Edwards

Notes: _____

Witness: N/A

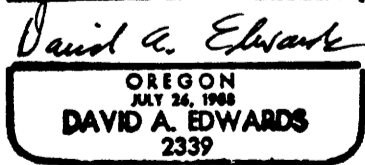

C.S. File 65/89-39